


G 6320

48607  
T9814

# T. 27 S. R. 17 E. W. M.

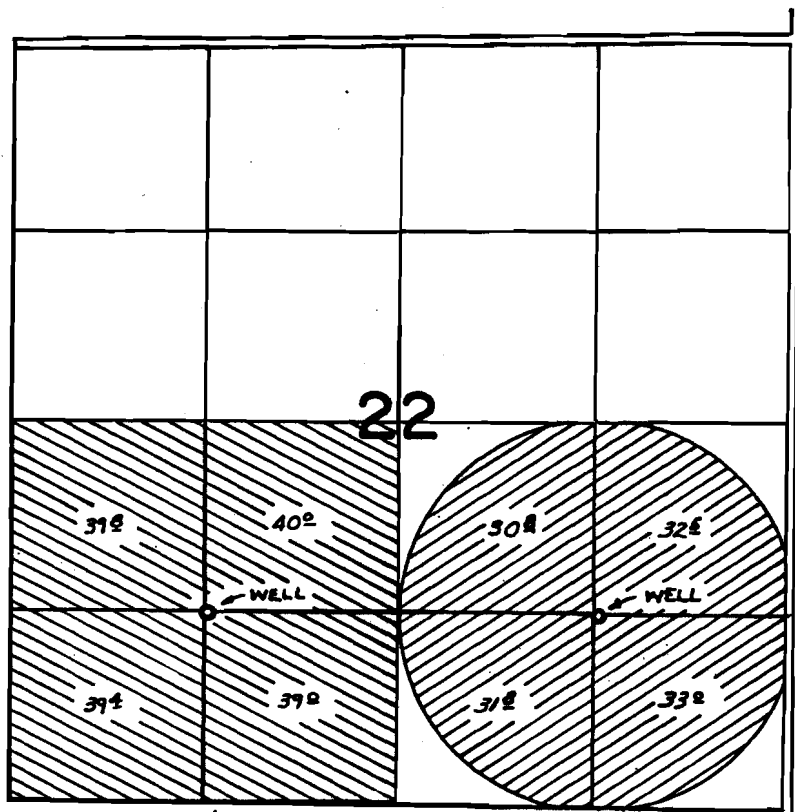

WELLS LOC: 1300' N. & 1310' W.; 1310' N. & 1340' E., BOTH FROM  
S $\frac{1}{4}$  SEC. 22

## FINAL PROOF SURVEY UNDER

Application No. G-6820 Permit No. G-6320   
IN NAME OF

GOLDEN RULE FARMS, INC.

Surveyed AUG. 25, 1978, by S.P. APPELEGATE.