


G-6957

48608

# T.27S.R.15E.W.M.

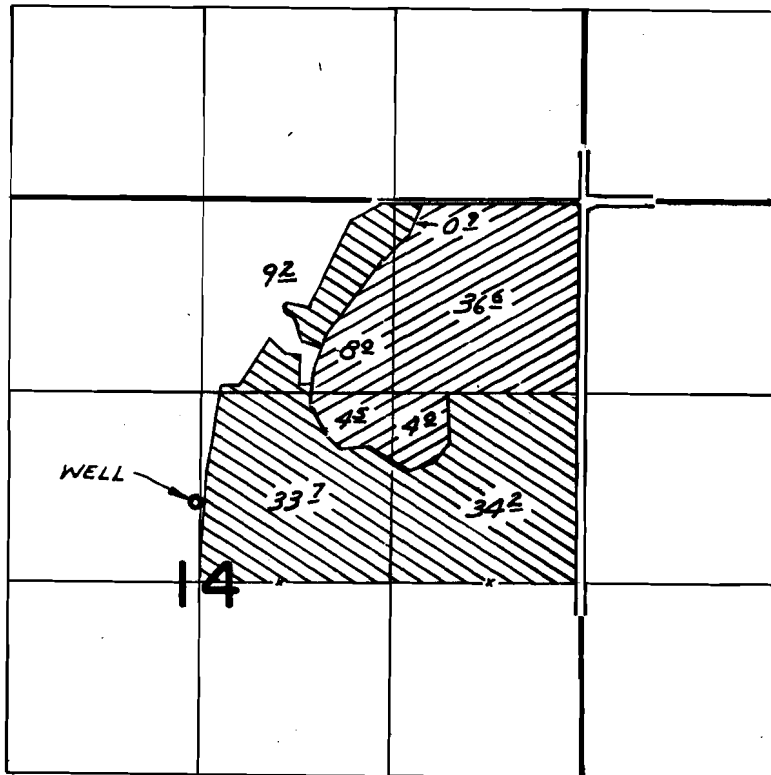

WELL LOG: 540' N. & 2660' W. FROM E. & COR. SEC. 14



SUPPLEMENTAL  
PRIMARY

## FINAL PROOF SURVEY UNDER

Application No. *G-7473* Permit No. *G-6957*  
IN NAME OF

.....*THELMA C. RUMSEY*.....

Surveyed *AUG. 30, 1978*., by *S.P. APPLGATE*