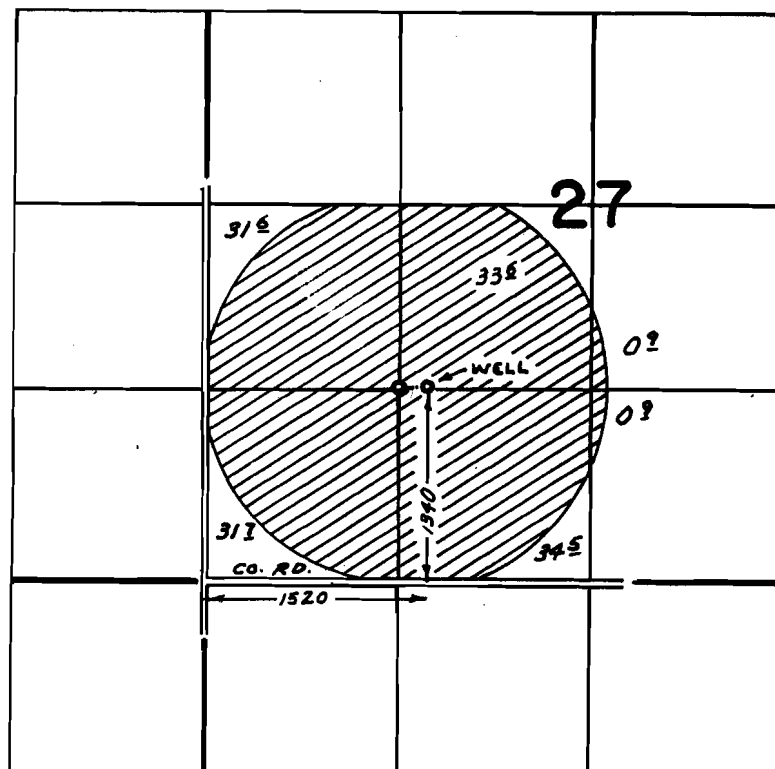


G 7134

48611

T.25S.R.13E.W.M.

**FINAL PROOF SURVEY**
UNDERApplication No. G-7567 Permit No. G-7134
IN NAME OF

RAY B. WAGNER - WAGNER FARMS

Surveyed AUG. 24, 1978, by S. P. APPLIGATE