


T.25S.R.14E.W.M.

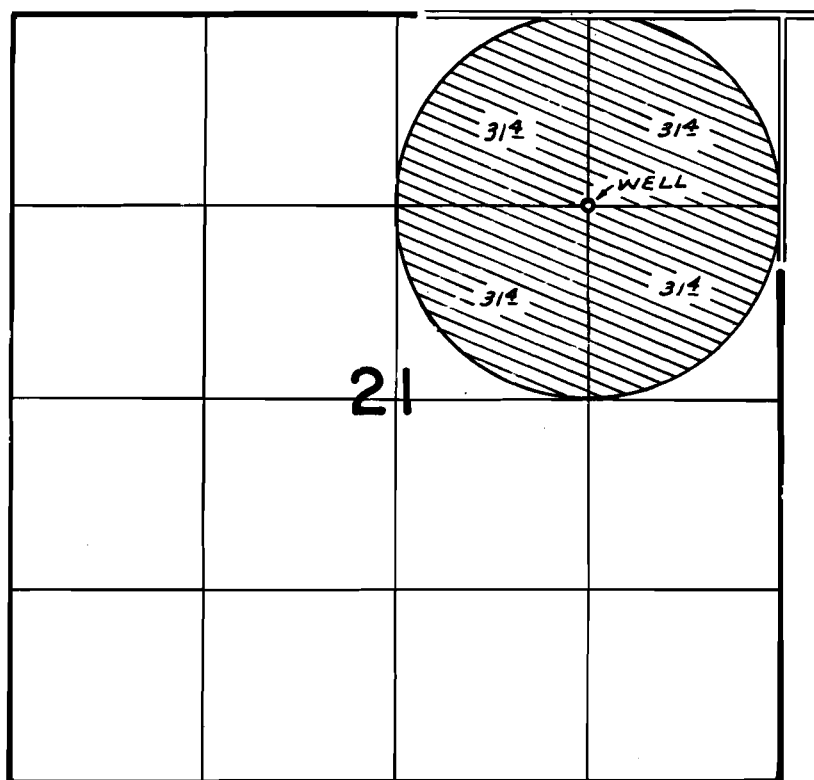

WELL LOC: 1320'S. & 1320'W. FROM N.E. COR. SEC. 21

FINAL PROOF SURVEY
UNDER

Application No. G-8550 Permit No. G-7767
IN NAME OF

CHESTER & HELEN TROUDY

Surveyed AUG. 29, 1978, by S.P. APPELEGATE