
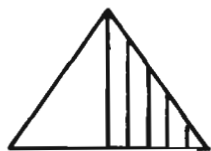


RECEIVED  
JUL 1 1974  
STATE ENGINEER  
SALEM OREGON

RECEIVED  
APR 29 1974  
STATE ENGINEER  
SALEM OREGON

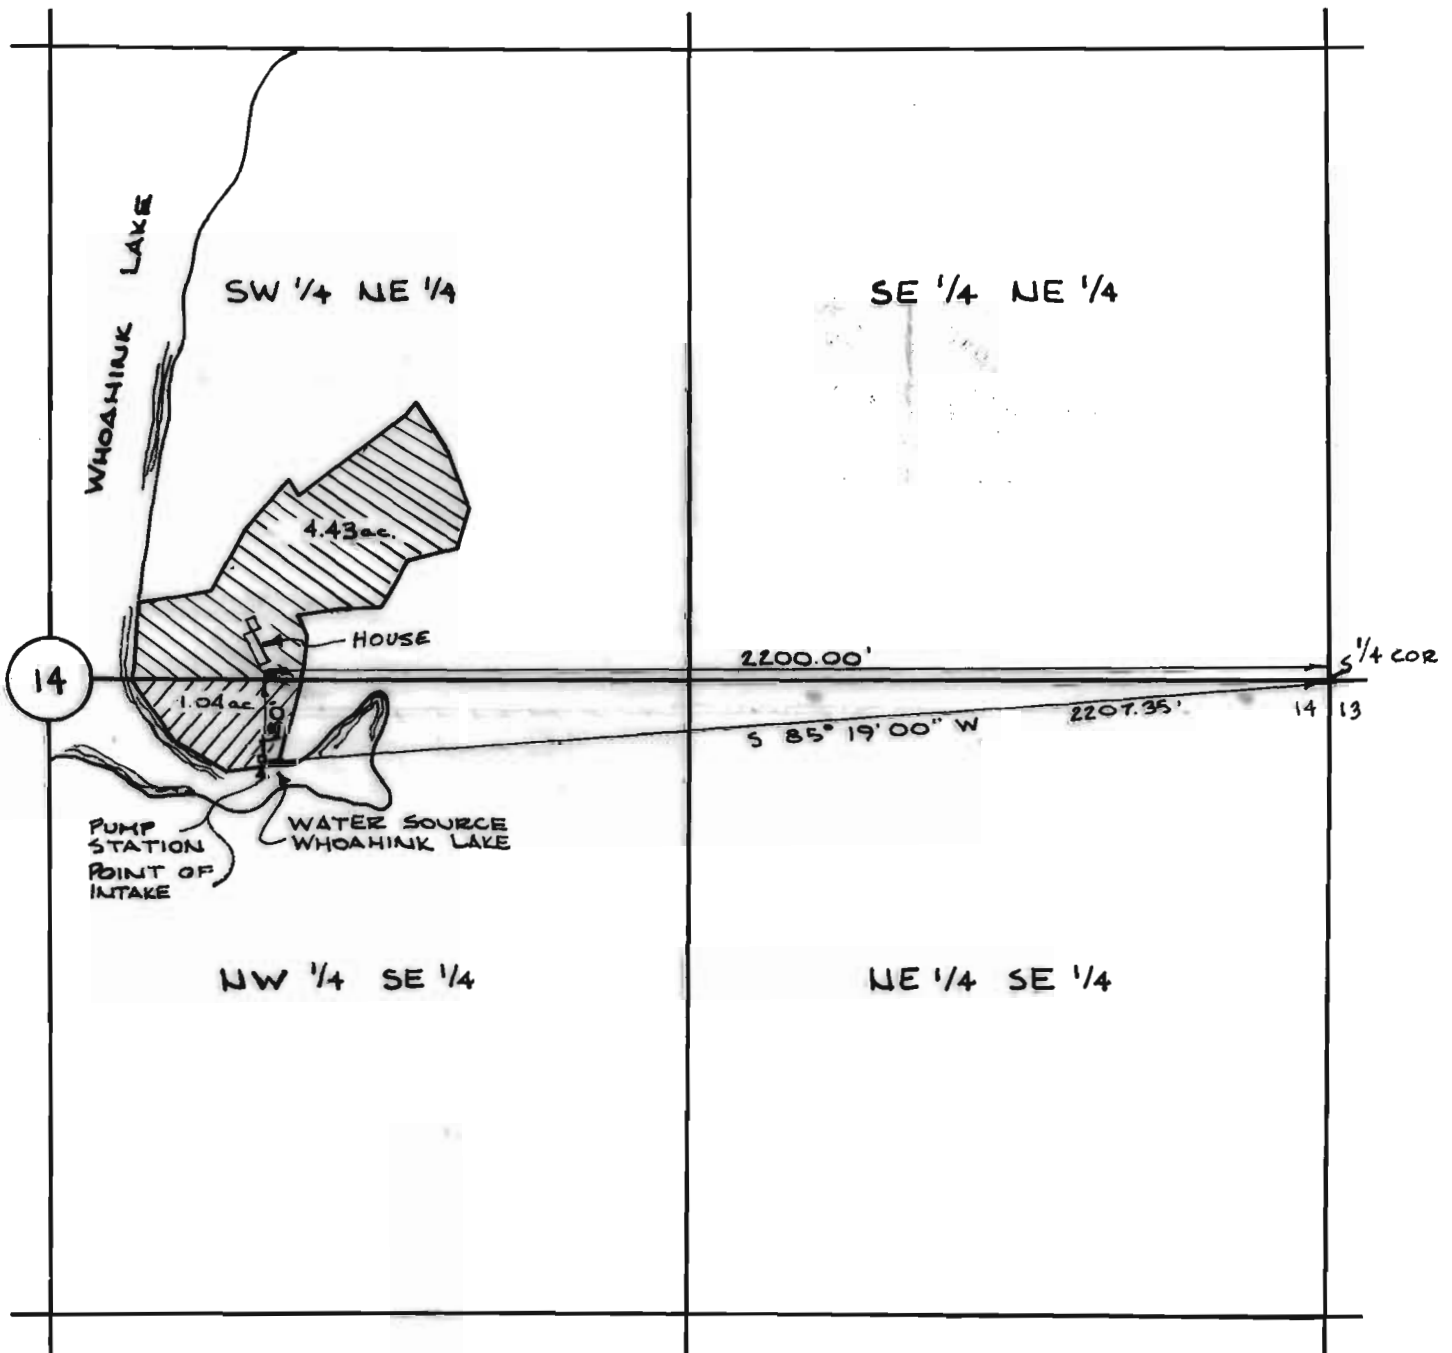

NORTH

SCALE: 1" = 400'



WATER RIGHT MAP  
EVERETT & GENEVA HANSON

EAST 1/2, SEC 14, T 19 S, R 12 W, W.M.  
LANE COUNTY, OREGON  
JUNE 1974

PLANTS & BRITTON, Inc.  
54 CENTENNIAL LOOP  
EUGENE, OREGON 97401  
503/686-9211

Application No. 57878  
Permit No. 39019