


T.19S.,R.12W.,W.M.

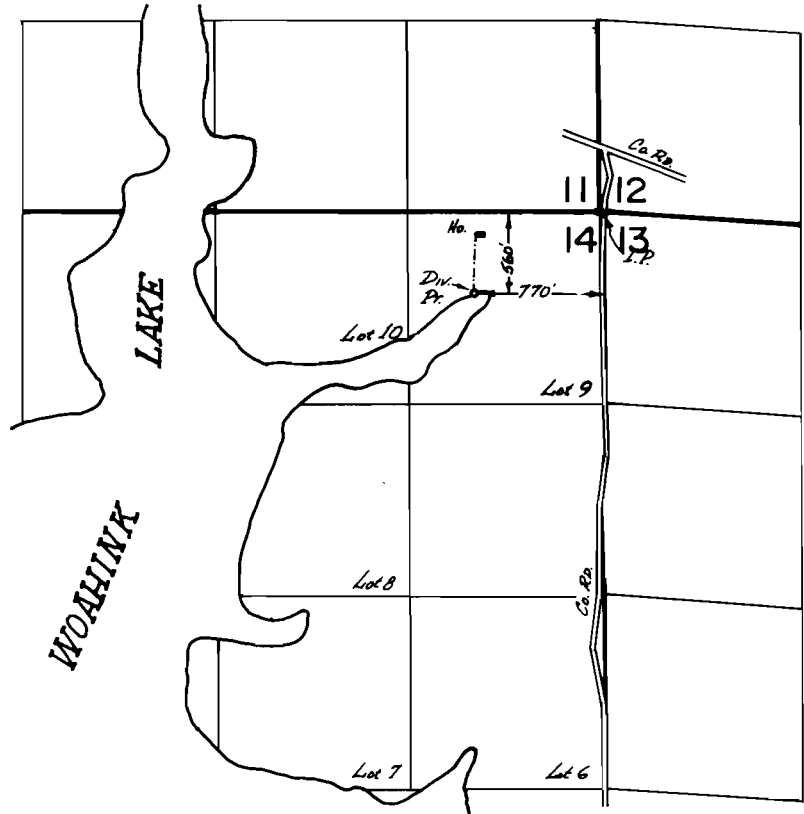

FINAL PROOF SURVEY
UNDER

Application No. 54792 Permit No. 41109
IN NAME OF

CLYDE W. & GLADYS E. MILLER

Surveyed May 16 1978, by A.P. Applegate