


T.19S. R.IIW., W.M.

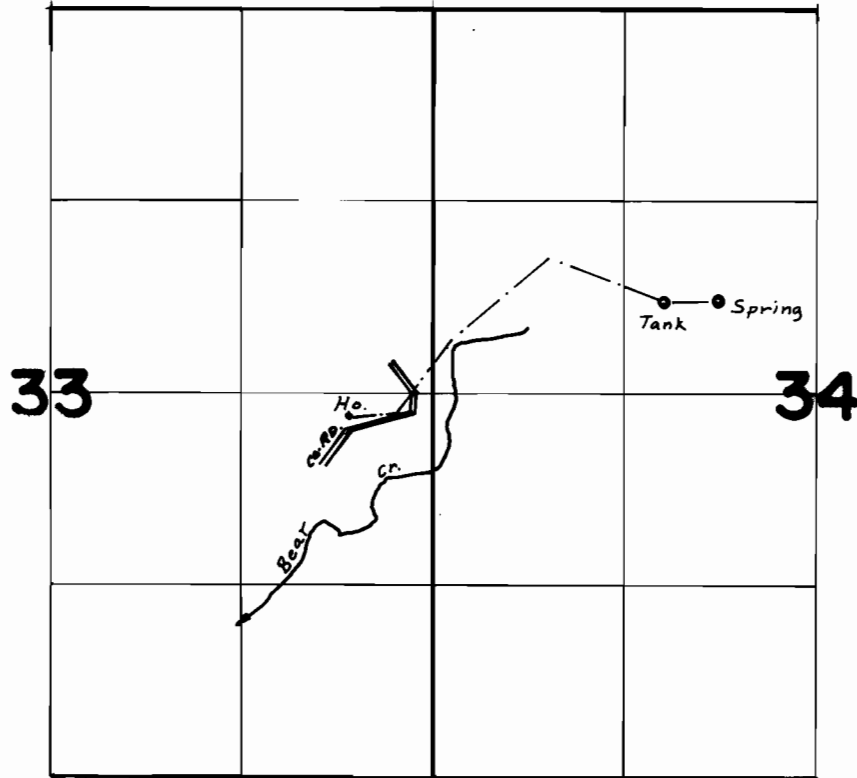

Spring Loc. 3280' N. & 1970' E. From S.W. Cor. Sec. 34

FINAL PROOF SURVEY UNDER

Application No. 55743... Permit No. 42089...
IN NAME OF

EDWIN A. & BERTHA A. DAHLMAN

Surveyed SEP. 13. 1978., by S.P. APPLGATE