T.5&6S. R.2W. W.M.

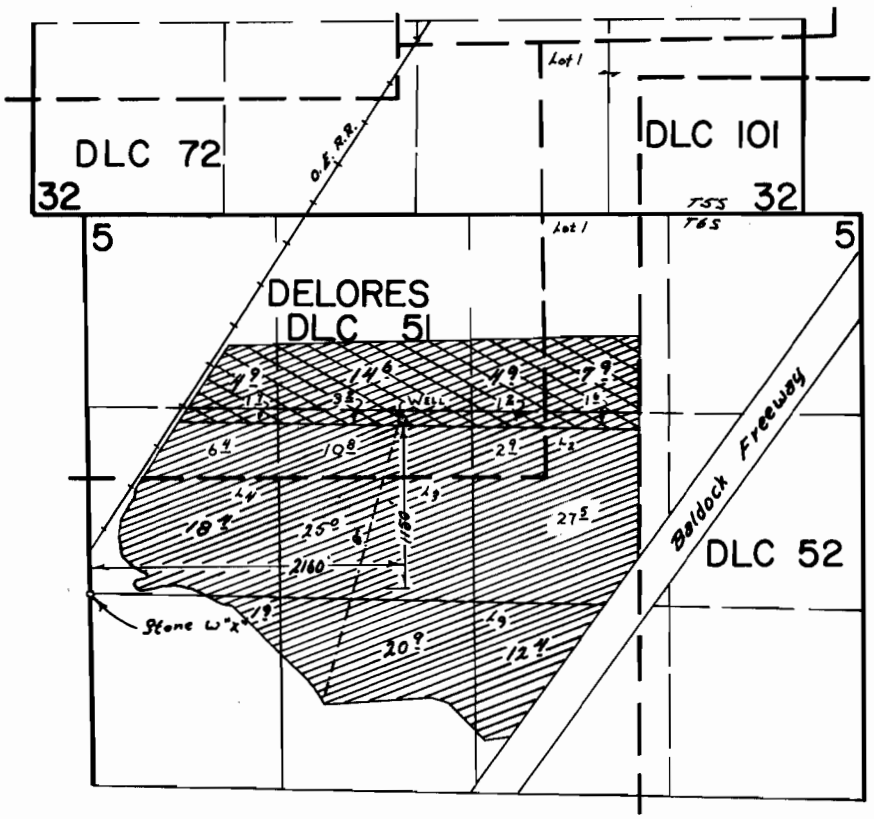

FINAL PROOF SURVEY
UNDER

Application No. G-3813 G-3280 Permit No. G-3244 G-2939

IN NAME OF

Ernest & Lola Zielinski

Surveyed July 25 19 73, by R.G. Mucken

DFN-6LL-138 TP