


# T8S. R.6W. W.M.

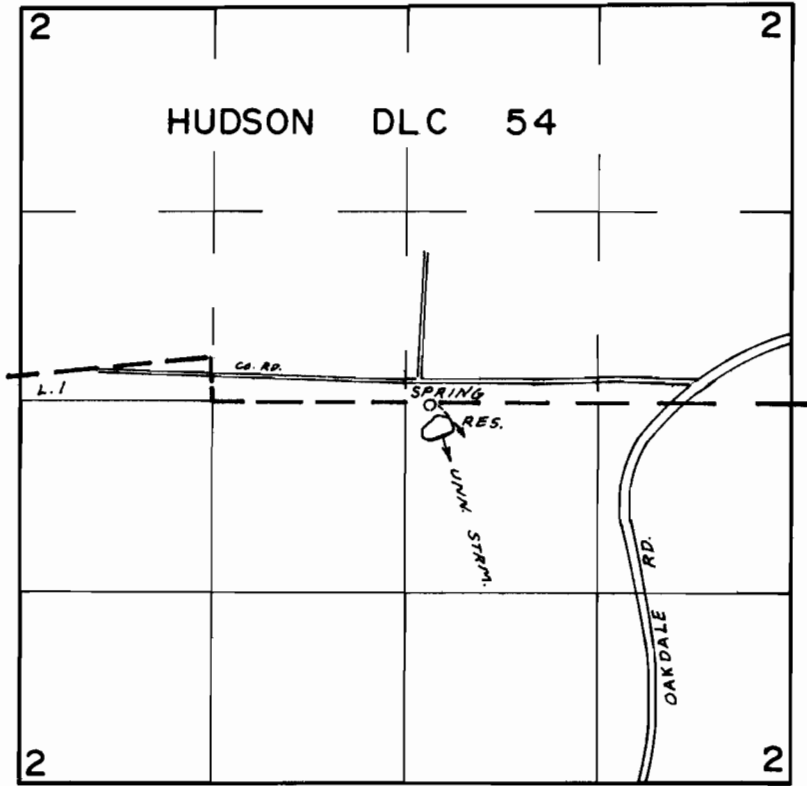

DAM LOC. 220'S & 1580'E FROM E'LY SW COR.  
HUDSON DLC 54

## FINAL PROOF SURVEY

UNDER

PLAT NO. R-46366 and No. R-5518

IN NAME OF

WAYNE BAILEY

Surveyed OCT. 13, 1975, by L.H. NUNN