


T.8S.,R.5W.,W.M.

SW 1/4 SEC. 28

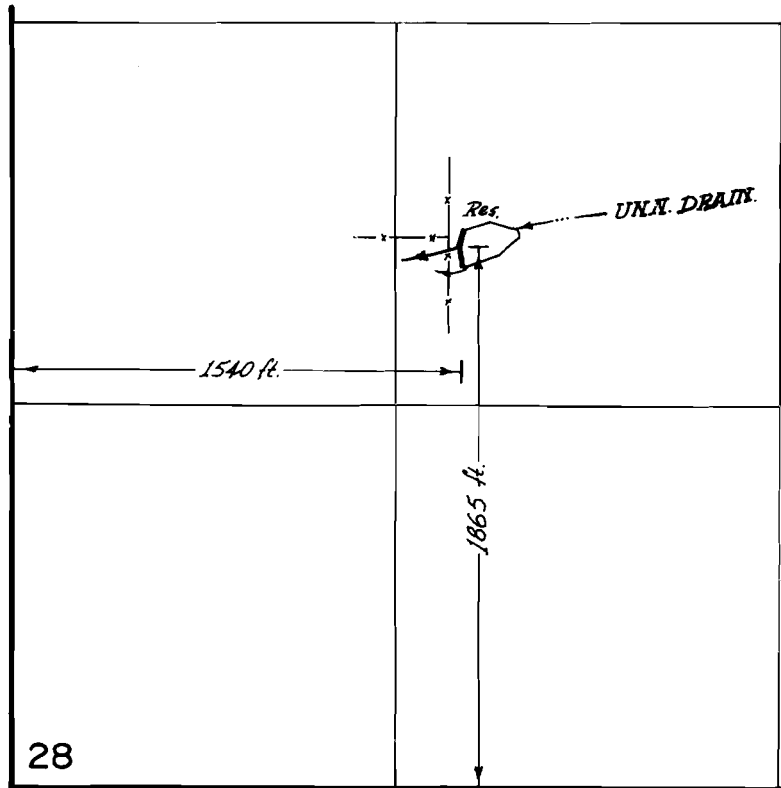

Scale: 1" = 660 ft.

FINAL PROOF SURVEY
UNDER

R-49939 R-6094
Application No. 49971 Permit No. 37569
IN NAME OF

SCOTT McARTHUR

Surveyed Oct. 13 19 78, by *A.P. Applgate*