

T.2N. R.13E. W.M.


RECEIVED

JUL 8 1977

WATER RESOURCES DEPT.
SALEM, OREGON

Application No. G 8256

Permit No. G 7682

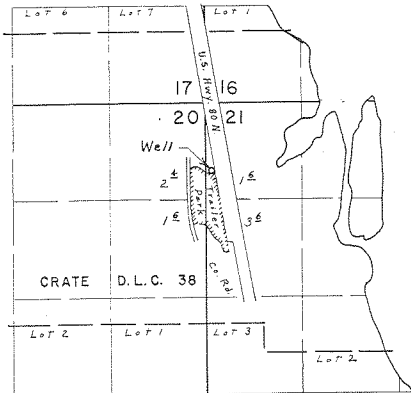

Well located 92° S. 80' E. From N.W. Cor. Sec. 21

FINAL PROOF SURVEY
UNDER

Application No. G-5025 Permit No. G-4732
IN NAME OF

MOBILE ASSOCIATES, INC.

Surveyed April 25, 1974, by David Norby