



Map of Section 9
Twp 29., S. R. 12. W. 4. M.
Coos County Ore
To accompany application
of S. A. Hufford & Perley Crowley
to appropriate water.

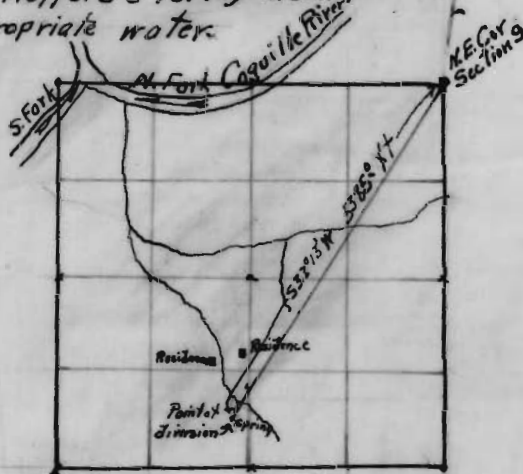

I D. L. Buckingham of Marshfield
Coos County Ore, do hereby certify that
this map was made from notes taken
during an actual survey made by me
on April 6, 1920 and that it correctly
shows the point of division and streams
and residences as described in the
accompanying application.

D. L. Buckingham

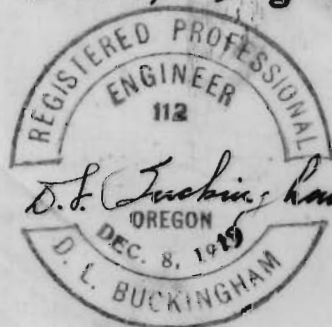

OFFICE OF STATE ENGINEER

RECEIVED

APR 14 1920

Application No. 7212

Permit No. 4553