


T. 5S.R.3W.W.M.

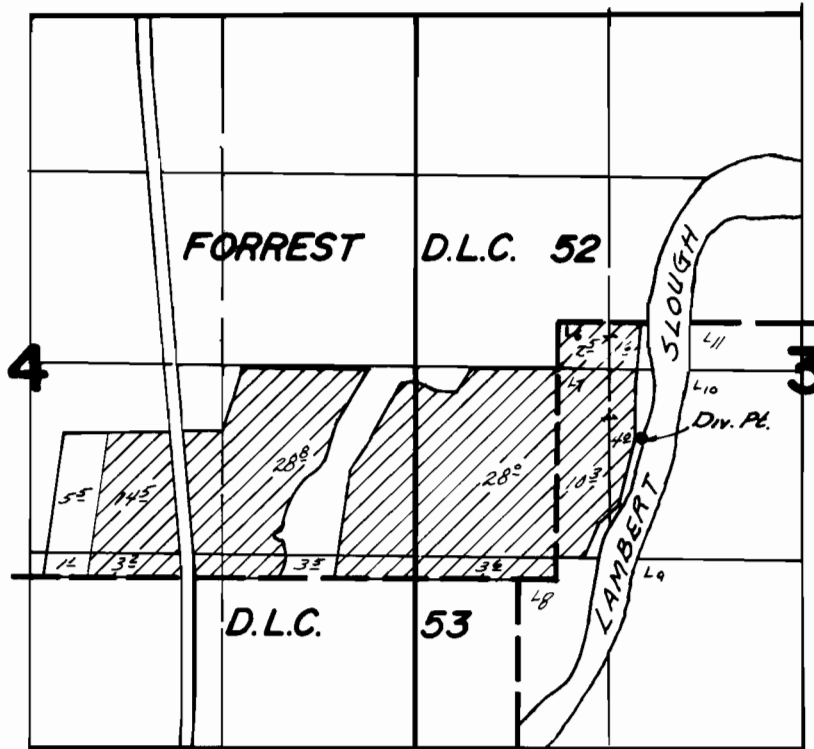

Div. Pt. Loc. - 2140' N & 1550' E from SW Cor. Sec. 3

FINAL PROOF SURVEY UNDER

Application No. 55370... Permit No. 41802...
IN NAME OF

IVAN M. GUBSER

Surveyed March 15, 1978., by L.H.Nunn