


T.5S.R.3W.W.M.

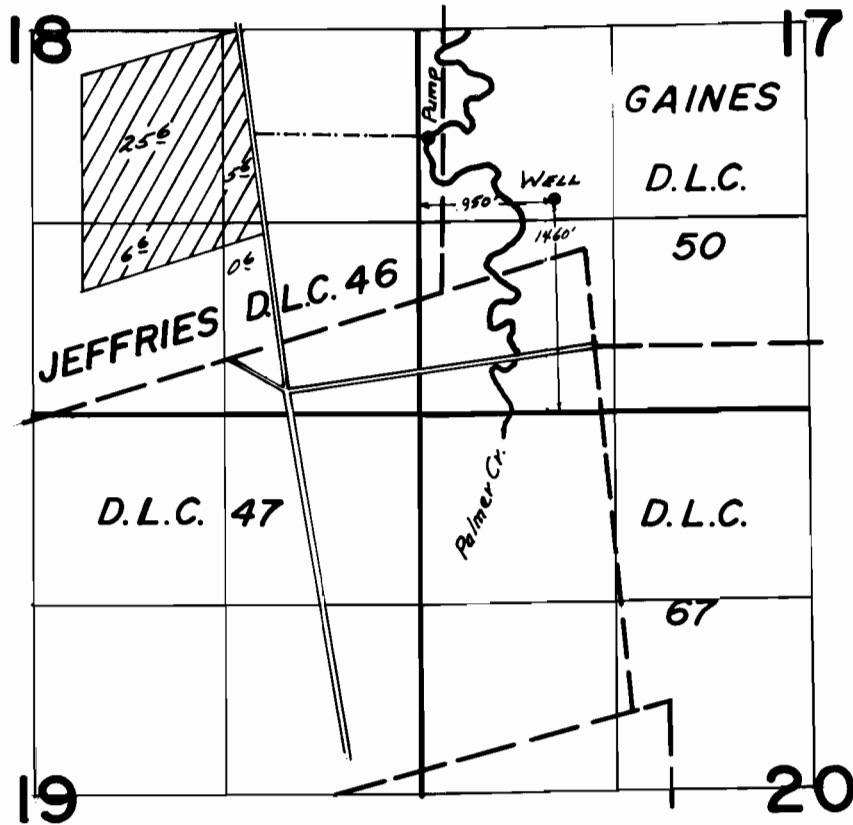

FINAL PROOF SURVEY UNDER

Application No. G-7767 Permit No. G-7268
IN NAME OF

CARL J. DAUENHAUER

Surveyed March 6, 1978, by L.H. Nunn