


T. 11S. R. 7W. W.M.

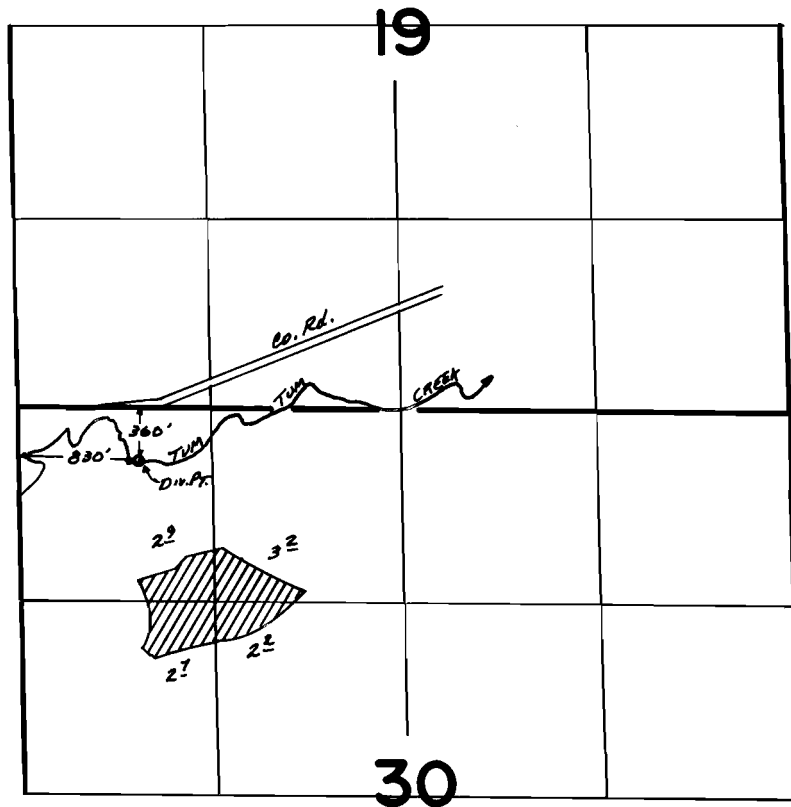

FINAL PROOF SURVEY
UNDER

Application No. 55217..... Permit No. 41412.....
IN NAME OF

.....JOHN HOWELL.....

Surveyed April 13, 1978, by J.S. Donaldson.....