


T. 16 S., R. 5 W., W.M.

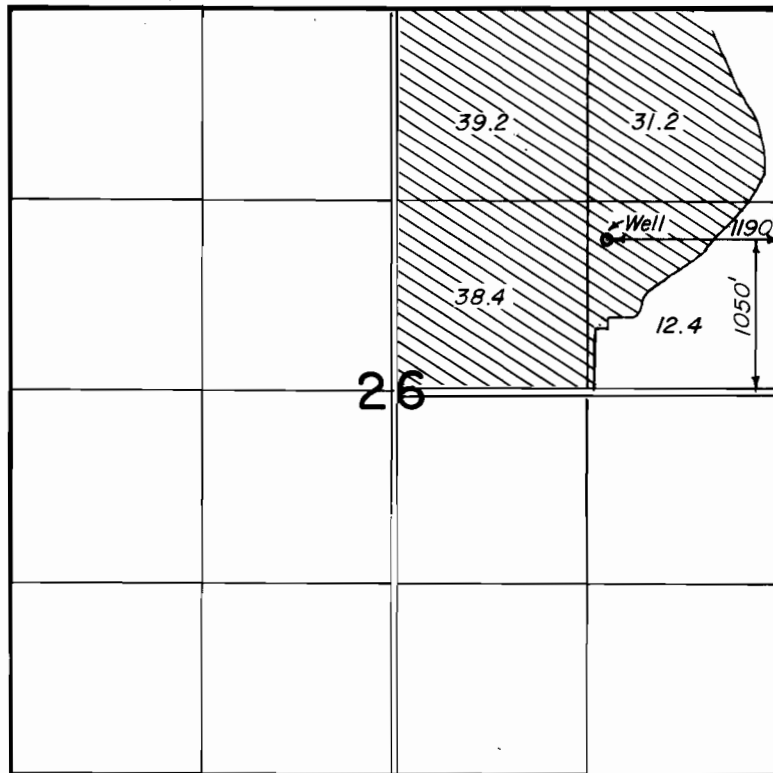

FINAL PROOF SURVEY
UNDER

Application No. G-8061 Permit No. G-7464
IN NAME OF

Mrs. EUGENE C. HILL

Surveyed MAY 23, 1978, by L. NUNN

DBQ-1JJ-208 *LN*