


P-40215  
SUP 48652  
49027

# T.I.S.R.2IE.W.M.

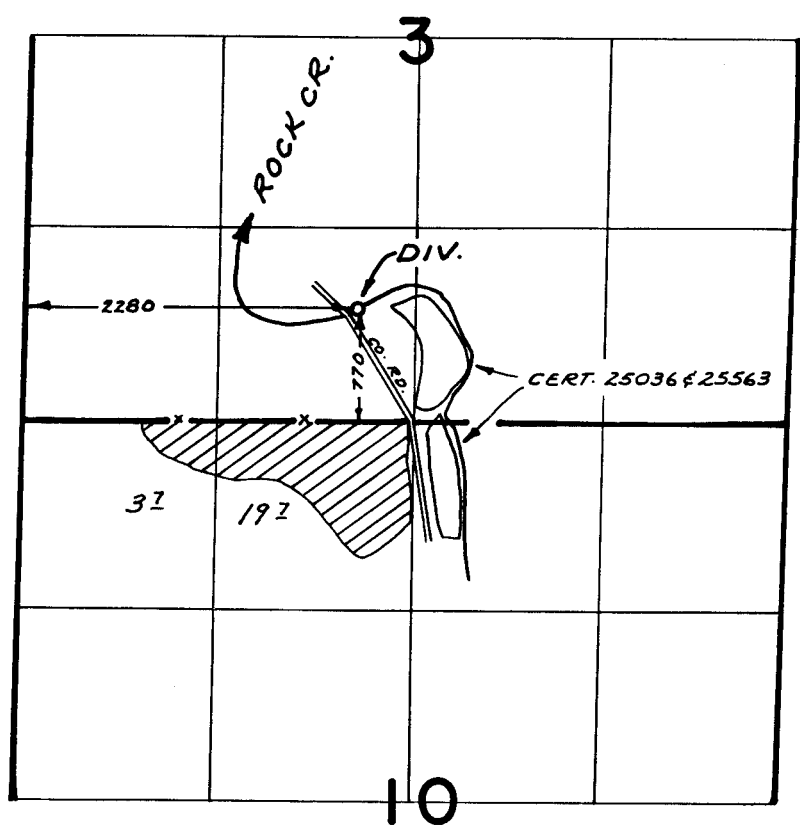

## FINAL PROOF SURVEY UNDER

Application No. 53896 Permit No. 40215  
IN NAME OF

ROBERT M. IRBY

Surveyed OCT. 25 1977, by R. MUCKEN