


P-40219

48654

48656

T.I.S.R.2IE.W.M.

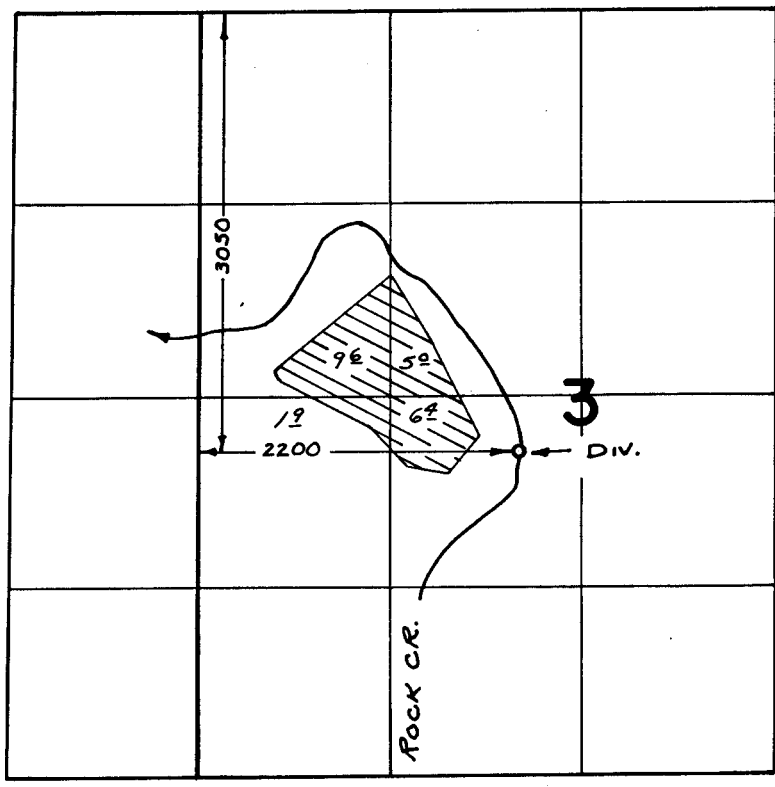

FINAL PROOF SURVEY UNDER

Application No. 53898 Permit No. 40217
54559 40939
IN NAME OF

.....ROBERT M. IRBY.....

Surveyed OCT. 25 1977. by R. MURKIN