


P-40219

48654  
48656

# T.I.S.R.2IE.W.M.

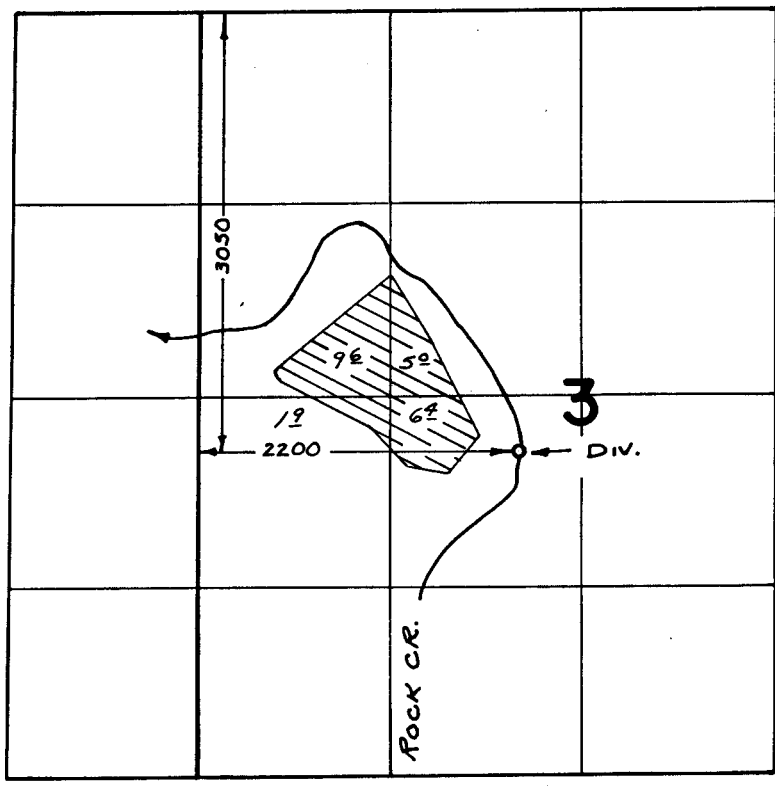

## FINAL PROOF SURVEY UNDER

Application No. 53898 Permit No. 40217  
54552 40939  
IN NAME OF

.....ROBERT M. IRBY.....

Surveyed OCT. 25 1977, by R. MURKIN