

42885

48679

Application No. 56214

Permit No. 42885


T. 37 S., R. 5 E., W. M.

SCALE = 4" = 1 mile

Journie Ck. & Mac.

LAKE OF THE WOODS

DIV. POINT LOC:
820 FE N AND 60 FE W
FROM SW COR SEC 11

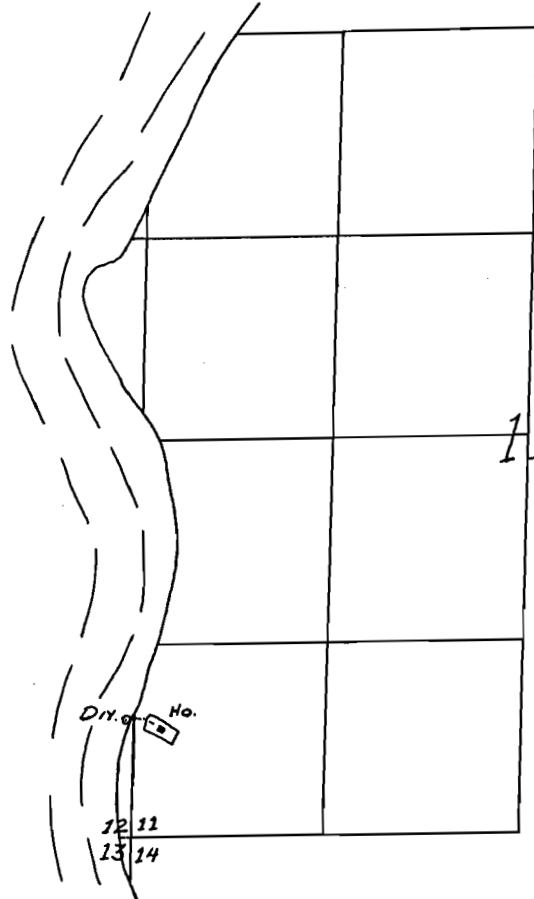

Div. Point No.

12 11
13 14

Cecil &

Ruth CARLAND

Lot 15 BLOCK D, Lot 7