


T.16S.,R.9W.,W.M..

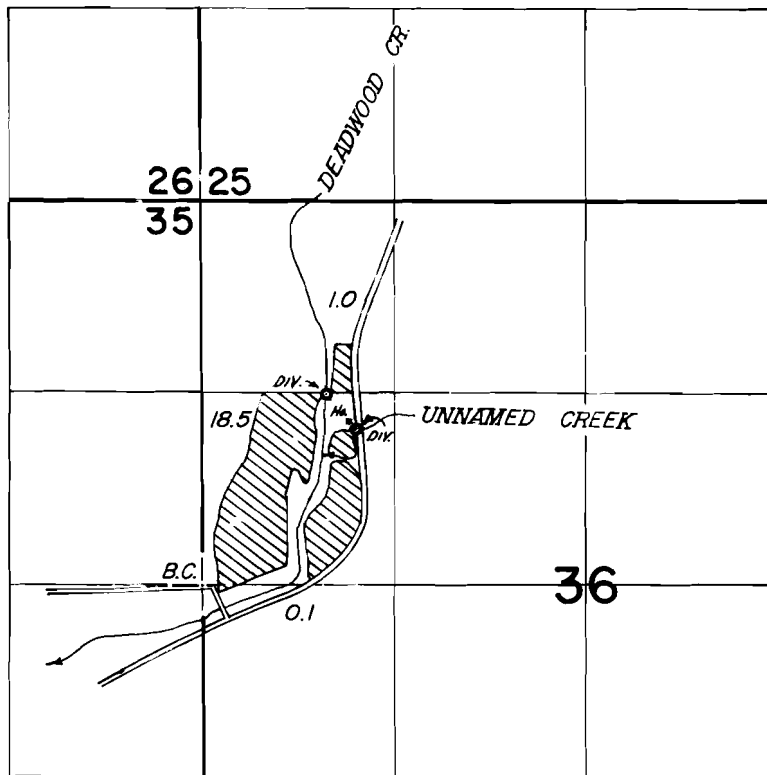

DIV. PTS. LOC.: DEADWOOD CR.; 1300' N. & 860' E., UNNAMED CR.,
1070' N. & 1060' E., Both From W. 1/4 Cor. Sec. 36

FINAL PROOF SURVEY
UNDER

Application No. 53826 Permit No. 40452
IN NAME OF

John W. Noell

Surveyed Sept 14, 1978 by S.P. Applegate

DBQ-3JJ-166 JCB