


T. 6 S. R. 10 W. W.M.

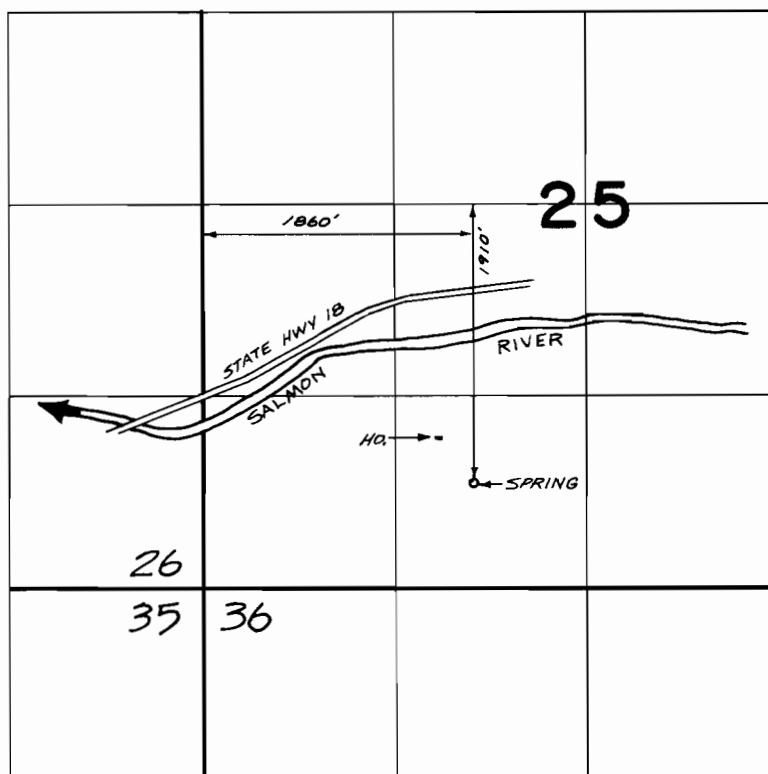

FINAL PROOF SURVEY
UNDER

Application No. 48686 Permit No. 36504
IN NAME OF

JOHN L. CHENOWETH

Surveyed JULY 18, 1974, by D. NORBY