


T.6S. R.1E. W.M.

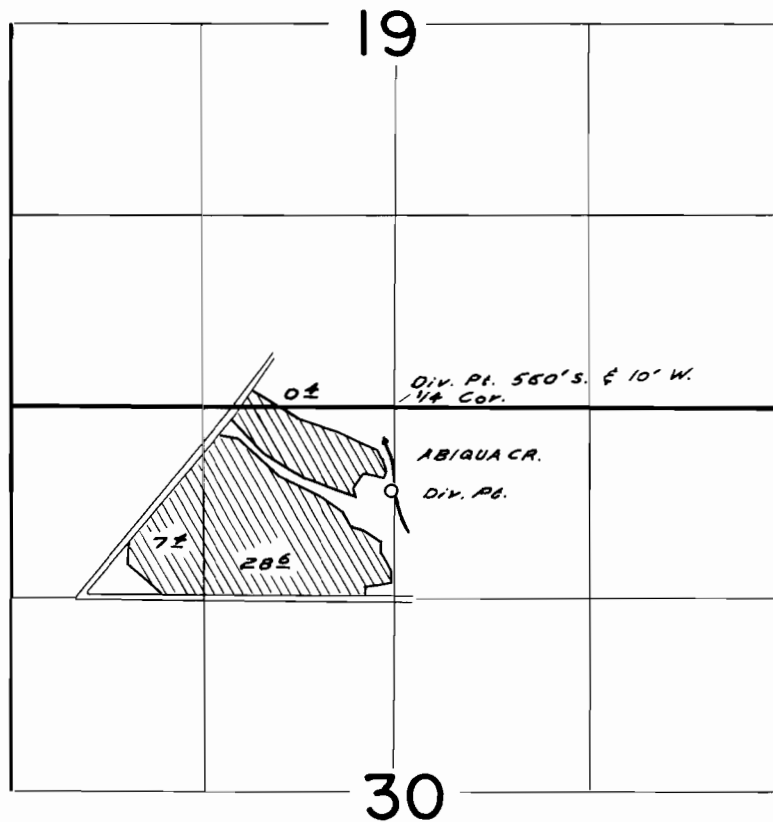

**FINAL PROOF SURVEY**  
UNDER

Application No. 34959 Permit No. 27418  
IN NAME OF

VERN HISKEY

Surveyed MAY 11 1965, by L. COLEBANK