


T.6S. R.6W. W.M.

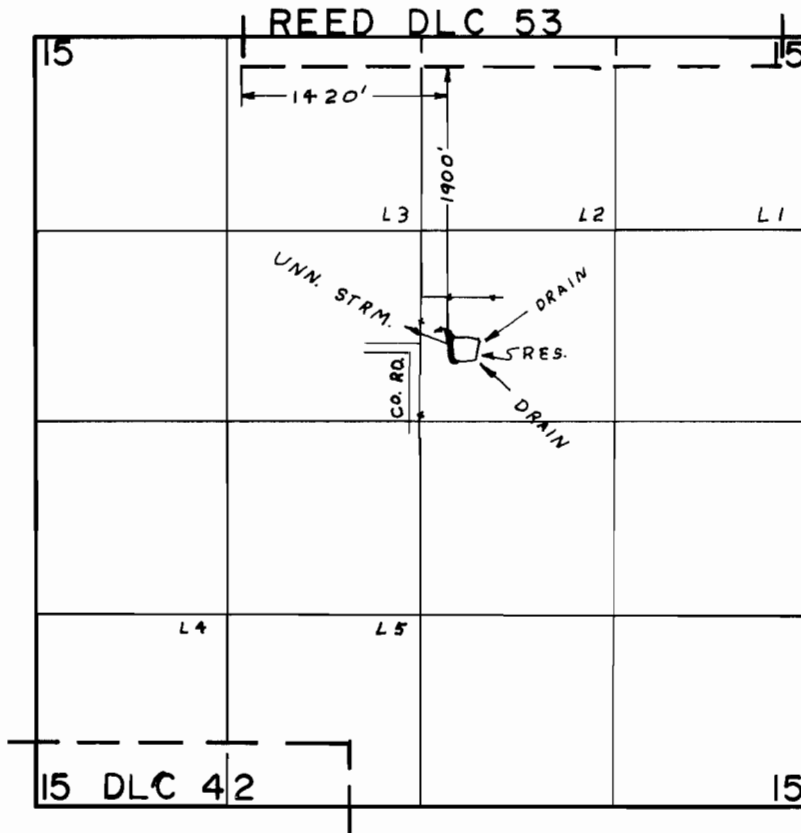

FINAL PROOF SURVEY UNDER

Application No. R-44285 Permit No. R-5121
IN NAME OF

IRVA G. & OLIVE E. BLAKE

Surveyed MAY 26 1975, by L. GOULD