


G-7120

T.1N. R.13E.W.M.

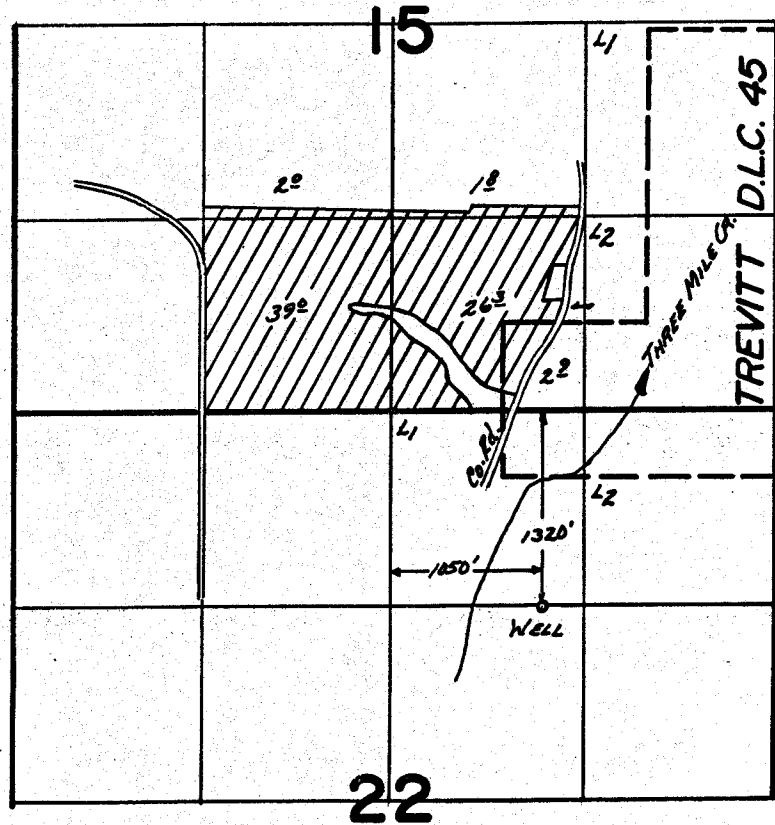


FINAL PROOF SURVEY UNDER

Application No. G-1607... Permit No. G-7120...
IN NAME OF

R. L. RENKEN

Surveyed March 29 1978, by L. H. Nunn

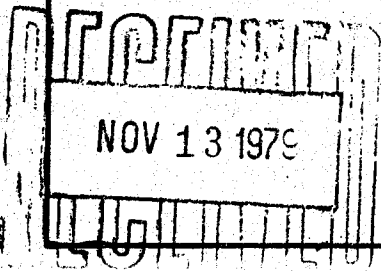

41065-572-124 622