


P-39201
48693

T.10S., R.23E., W.M.

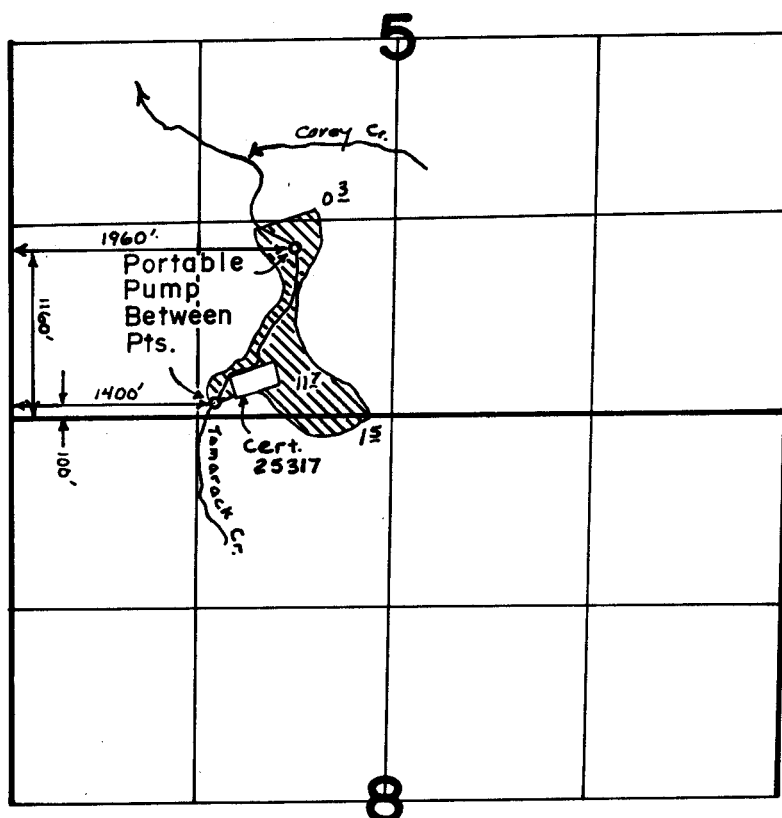

FINAL PROOF SURVEY
UNDER

Application No. 52003 Permit No. 39201...
IN NAME OF

ROBERT HELMS

Surveyed AUG. 21, 1976, by D. NORBY