


T. 4S.R.4W.W.M.

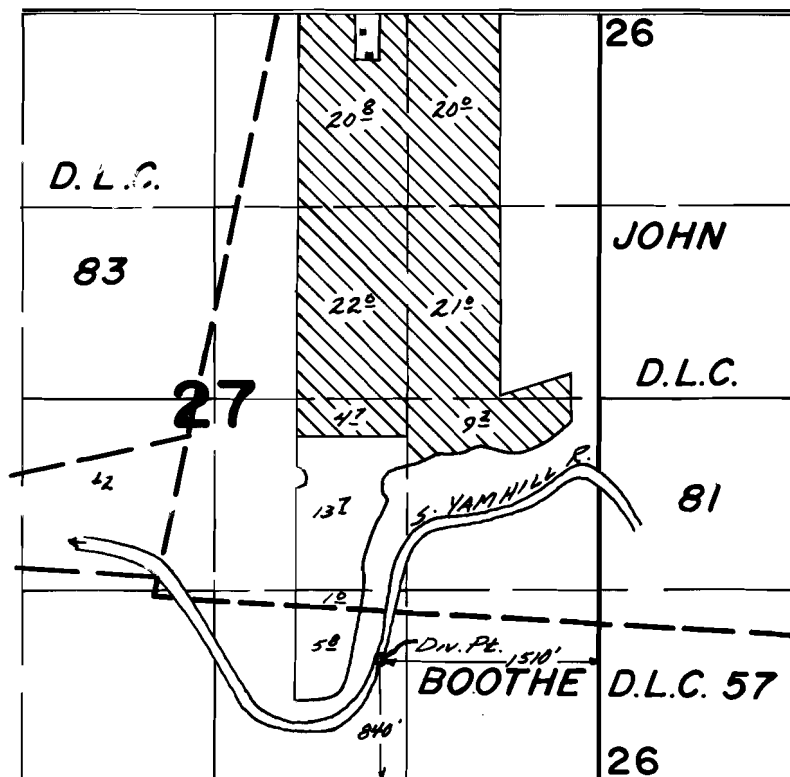

FINAL PROOF SURVEY UNDER

Application No. 50822 Permit No. 38370...
IN NAME OF

JOHN H. OTTING

Surveyed March 16 1978., by L.H. Nunn