


FAIRVIEW IRRIGATION DITCH

SCALE 1 INCH = 40 CHAINS

I, F.A. Rice, of Prineville Oregon, do hereby certify that this map was made from notes taken during an actual survey made under my immediate supervision on September 22nd. 1910, and that it correctly represents the works in the accompanying application; together with the location of streams and other ditches in the immediate vicinity; and has written thereon the area in each smallest legal subdivision which it is proposed to irrigate.

Fred A Rice

Surveyor

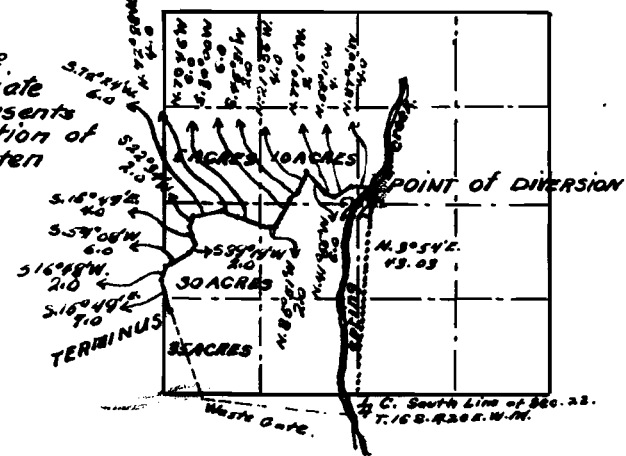

Approved 10/12

Record No 480

P.L.B.

487