


T.14S. R.5W., W.M.

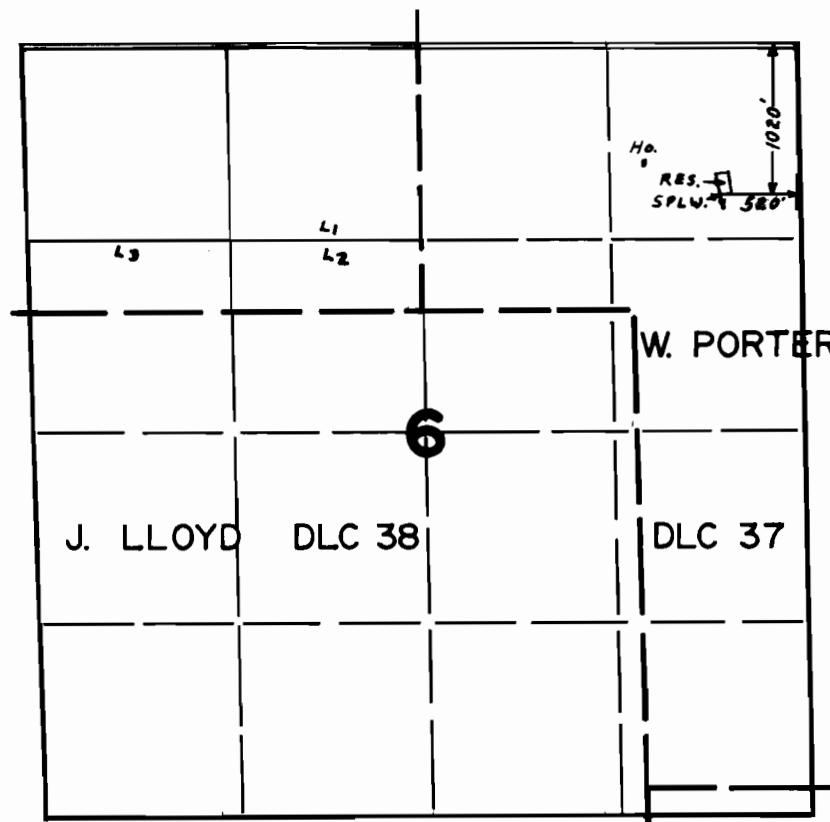

FINAL PROOF SURVEY
UNDER

R-48788 R-5917
Application No. 48789 Permit No. 36576
IN NAME OF

ROBERT C. LEE

Surveyed OCT. 4, 1978, by S.P. APPLGATE