


T. 13S. R. 5W. W.M.

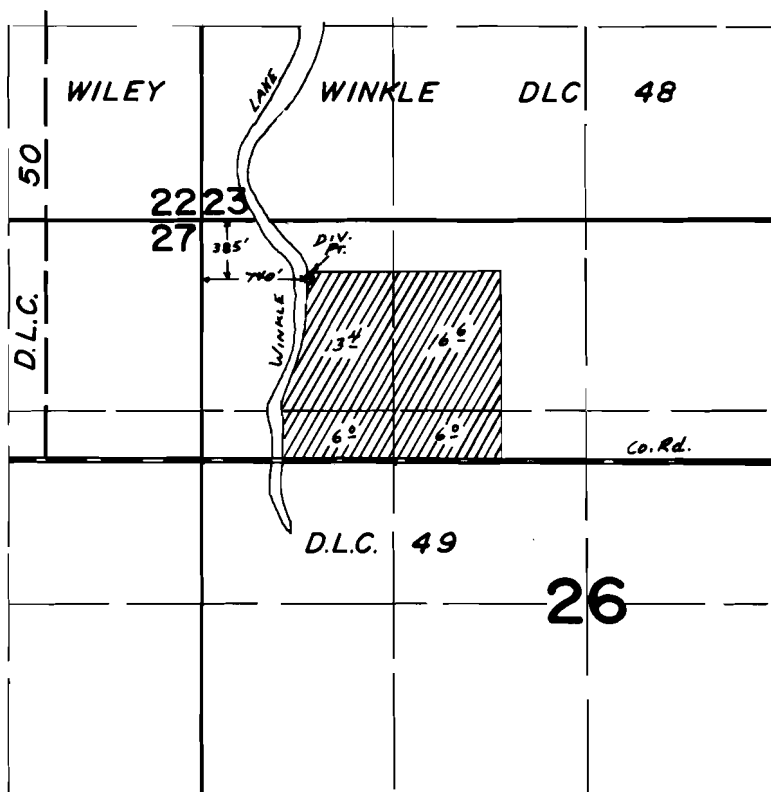

FINAL PROOF SURVEY UNDER

Application No. 55432.. Permit No. 41815.....
IN NAME OF

GORDON HYEN LOESCHEN.....

Surveyed March 23 1978, by J.S. Donaldson...