


T.30S. R.15W. W.M.

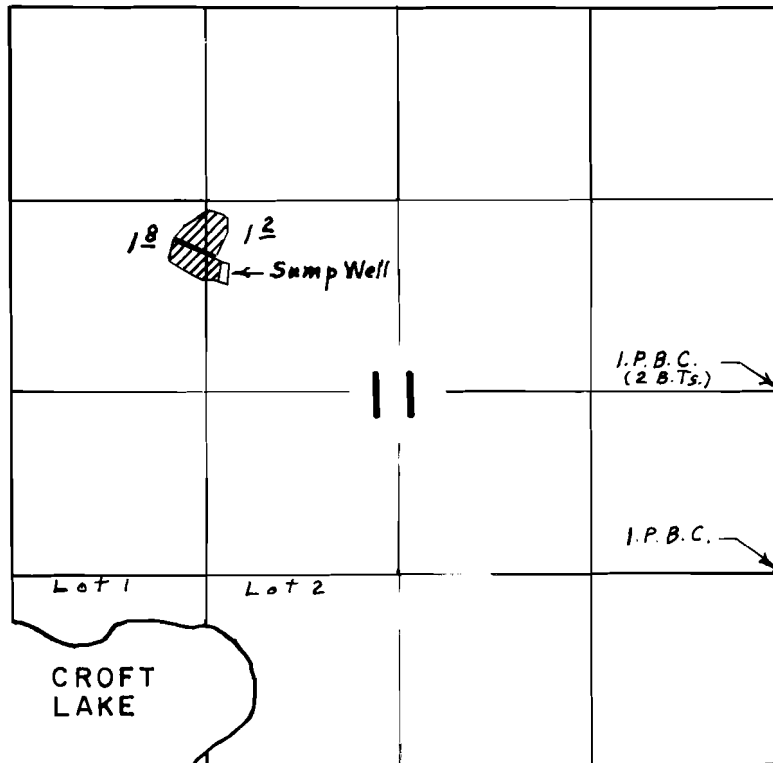

Sump Well located 820' N. & 3830' W. from E. $\frac{1}{4}$ Corner Section 11

FINAL PROOF SURVEY UNDER

Application No. G-5375. Permit No. G-4959.
IN NAME OF

George W. Vincent

Surveyed Sept. 2, 1976, by L. E. Gould.