


T. 3 S., R. 1 E., W. M.

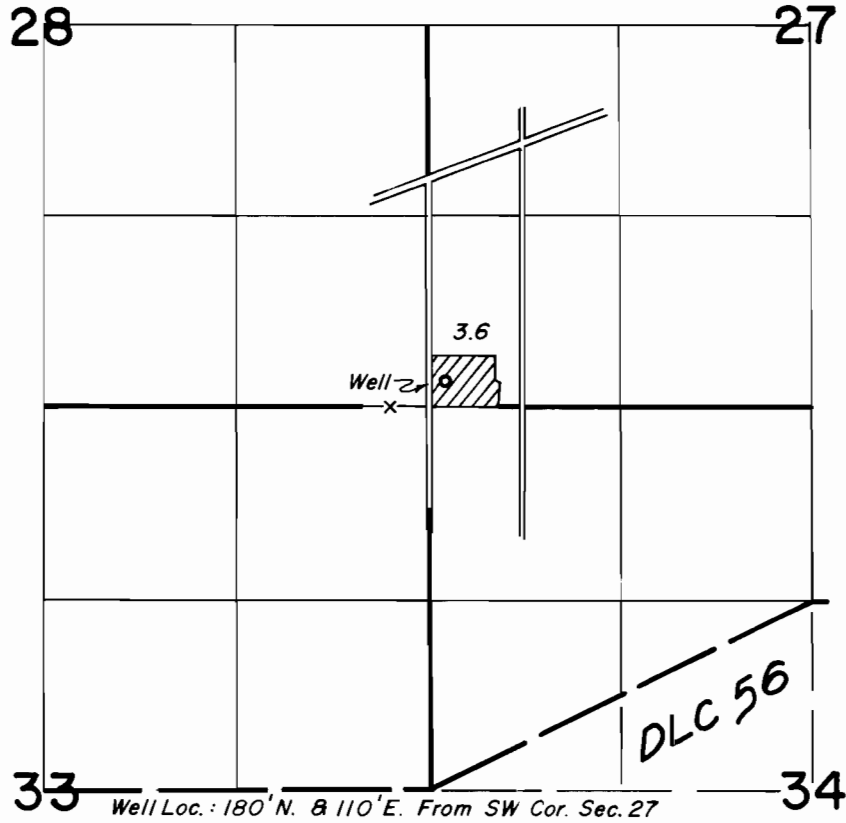

FINAL PROOF SURVEY
UNDER

Application No. G-7722 Permit No. G-7171
IN NAME OF

Clarence C. Lepinsky

Surveyed Feb 8, 1978, by AC Brown