


# T.38S.R.3E.W.M.

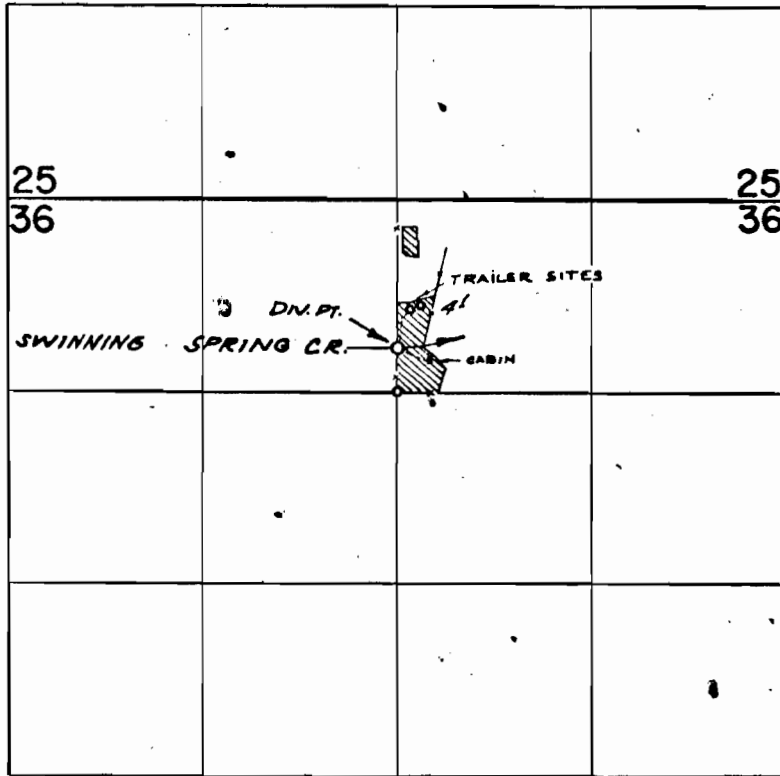

DIV. PT. LOC: 300' N. 6' 10" E. FROM SW. COR. NW 1/4 NE 1/4 SEC. 36

## FINAL PROOF SURVEY UNDER

*Transfer B-135*

Application No. *38693*..... Permit No. *28786*.....  
IN NAME OF


.....*MARK E. & JOAN N. BOYDEN*.....

Surveyed *OCT. 20, 1971*., by *R. MUCKEN*

Grizzly Cr. & misc.

MAP  
Application of JESSE L. NEIL of  
Jackson Co. Ore. for permit to the waters  
of Grizzly Creek, Hoxia Cr, Willow Cr, Spring  
Creek, Jackson Co. Ore. all tributary to  
Klamath River for the pur-  
pose of irrigation on lands as shown on plat.  
March 11<sup>th</sup> 1925.

Survey in the field made by  
Fred N. Cummings C.E.  
showing the same correctly showing  
diversions, lands to be irrigated  
and streams in immediate vicinity

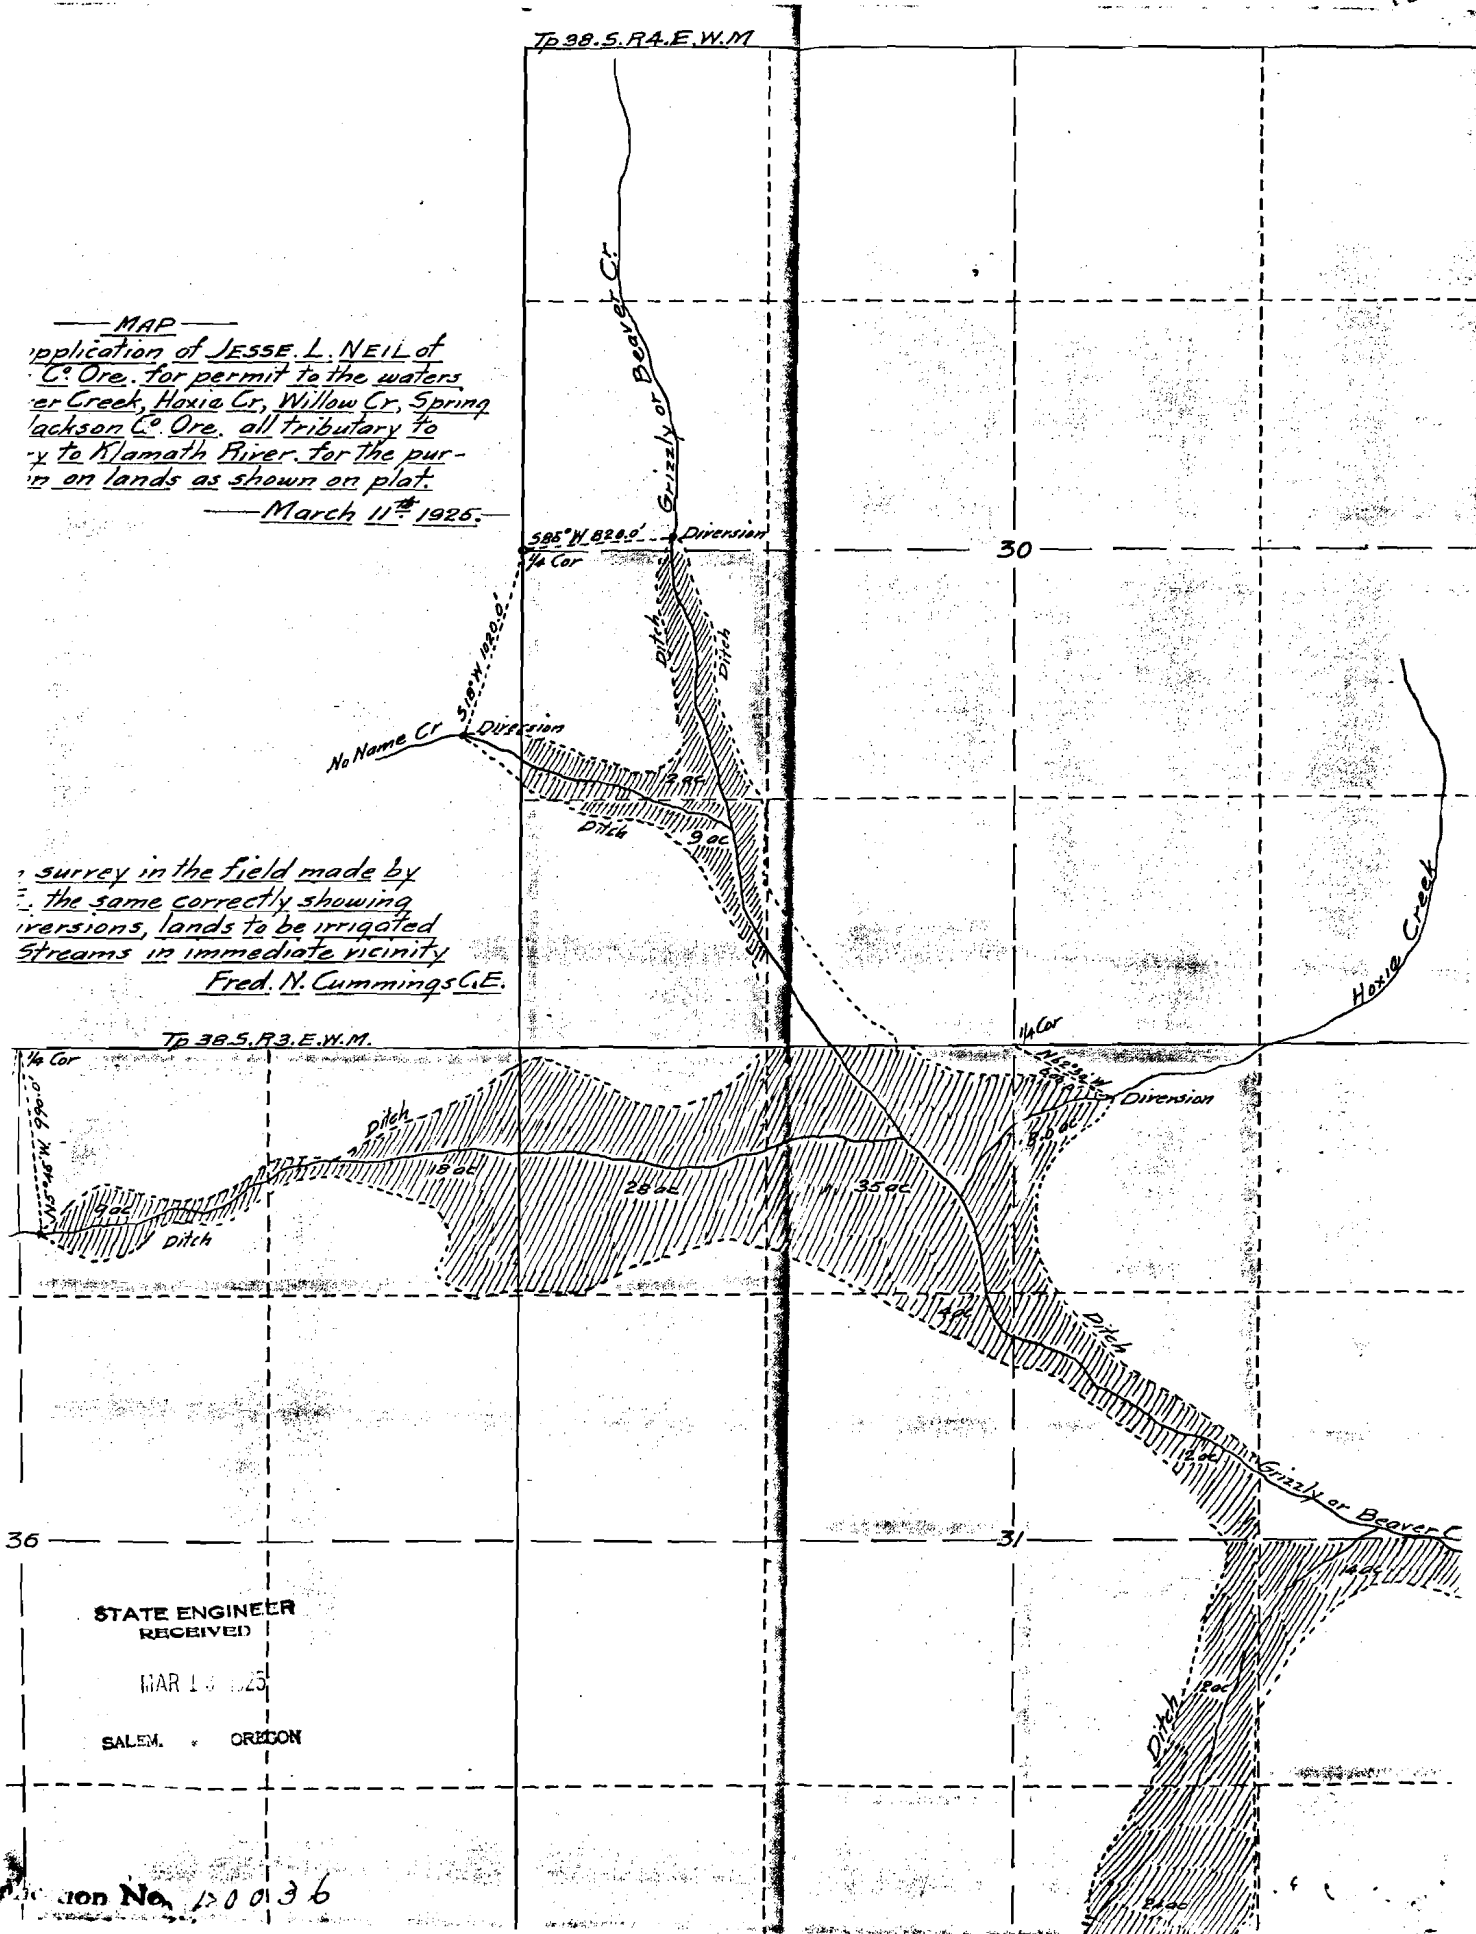

STATE ENGINEER  
RECEIVED

MAR 13 1925

SALEM, OREGON