


28786

48718

# T.38S.R.3E.W.M.

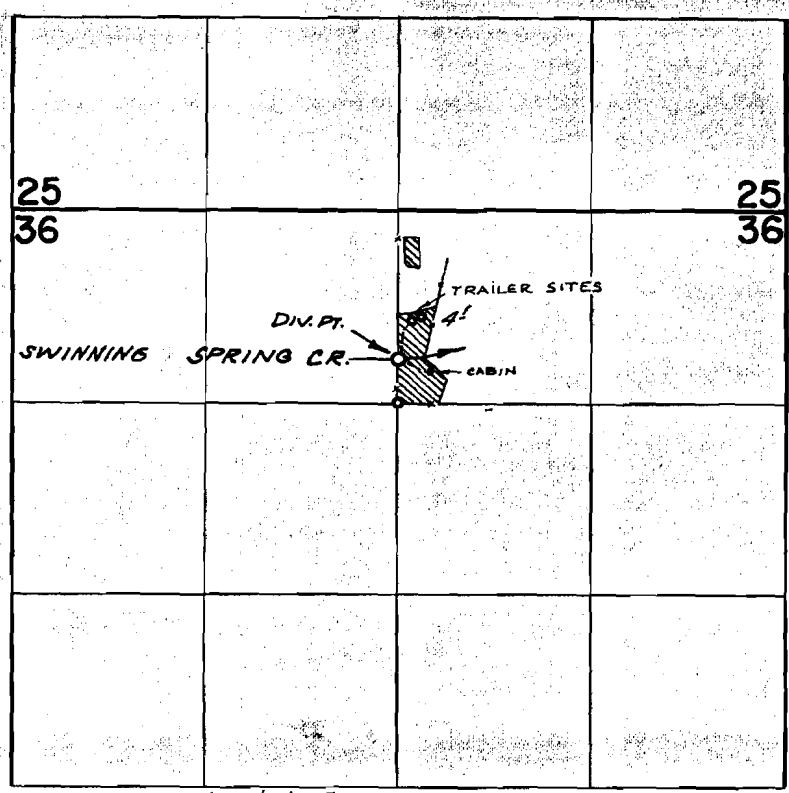

DIV. PT. LOC: 300' N. 8' 10" E. FROM SW. COR. NW 1/4 NE 1/4 SEC. 36

*Stuzly ck. : mac.*

## FINAL PROOF SURVEY UNDER

*Transfer B-135*

Application No. *38623* Permit No. *28786*  
IN NAME OF

*MARK E. & JOAN N. BOYDEN*

Surveyed *OCT. 20, 1971*, by *R. MUCKEN*