


R-5988
✓(36894)
48720
48719

T.39&40S. R.4E., W.M.

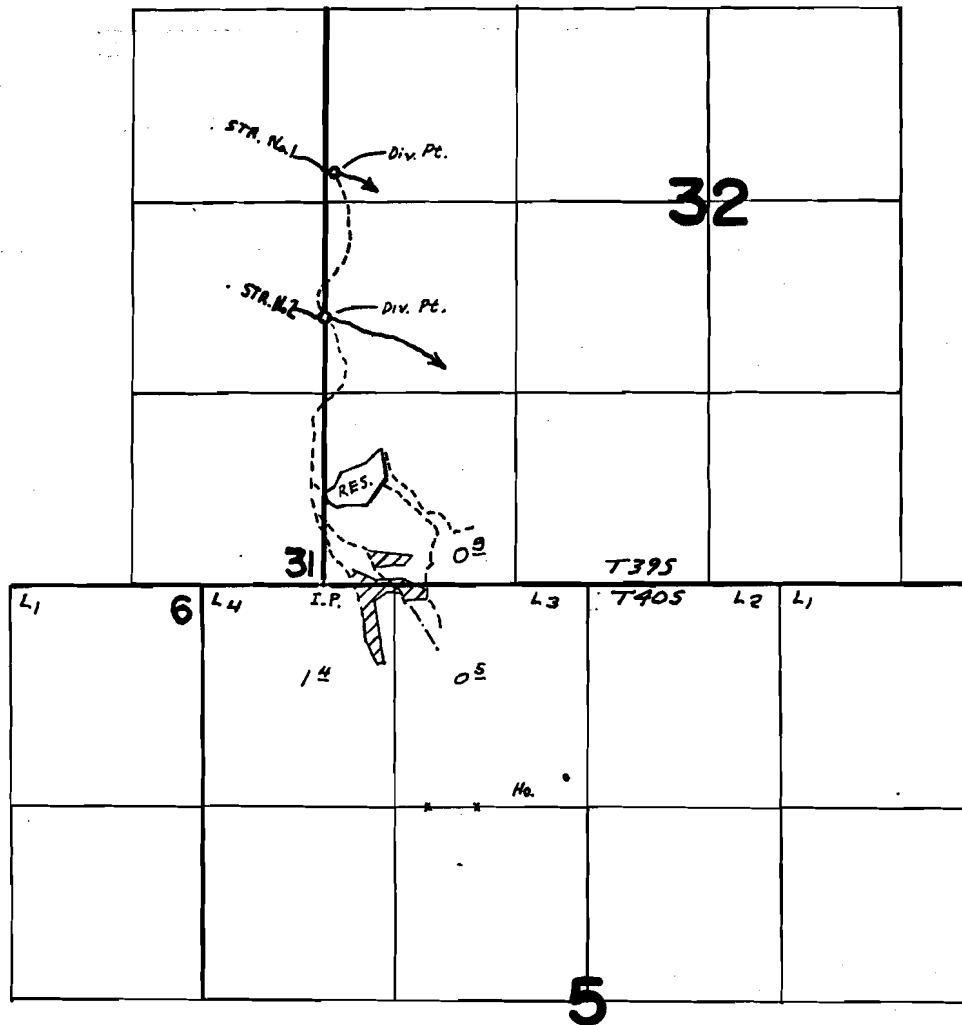

Div. Pts. Loc. : 1850' N & 5' E ; & 2850' N & 70' E Both From S.V. Cor SEC 32
RES. Loc. 700' N & 420' E FROM SW COR SEC 32

FINAL PROOF SURVEY UNDER

R-49219 R-5988
Application No. 49220 Permit No. 36894...
IN NAME OF

DONALD ROWLETT

Surveyed SEP. 19, 20 1974, by R.G. MUCKEN