


R-5988
 ✓(36894)
 48720
 48719

T.39&40S. R.4E., W.M.

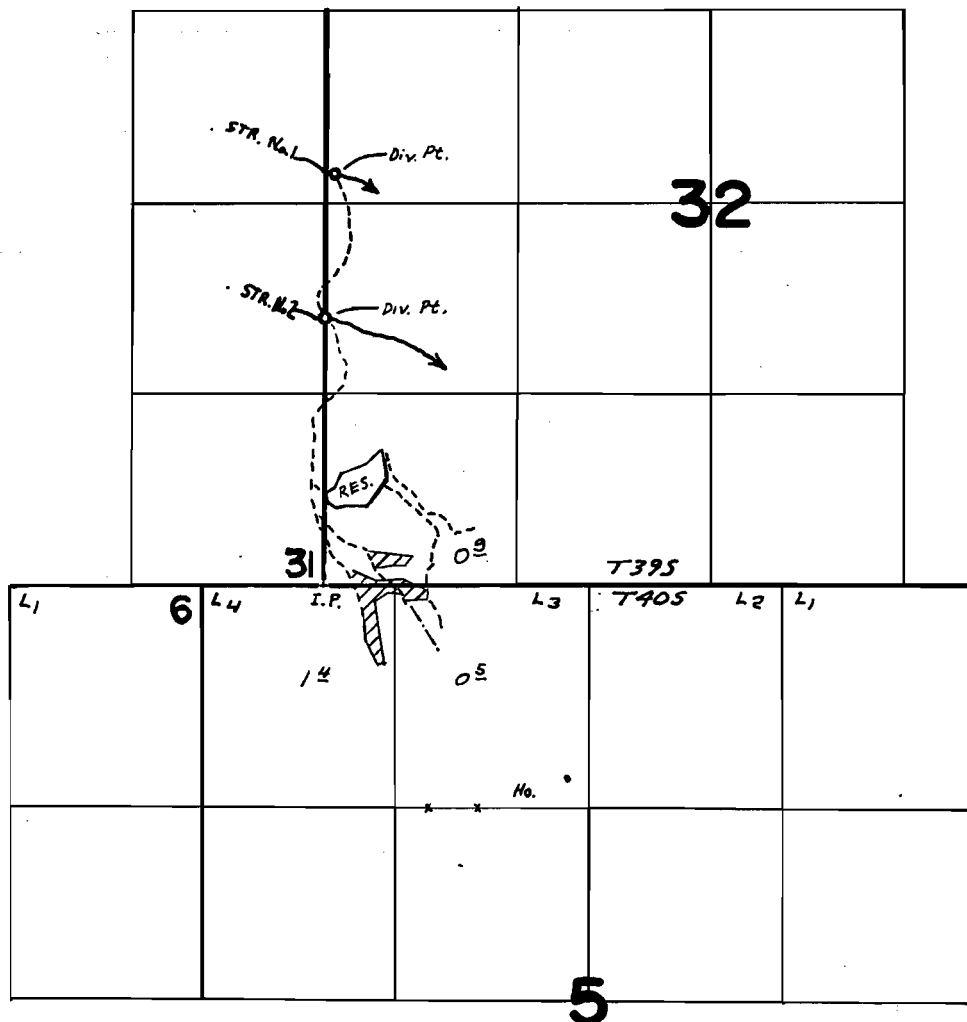

Div. Pts. Loc. 1: 1850' N 15' E; & 2850' N 70' E Both From S.W. Cor SEC 32
 RES. Loc. 700' N 1420' E FROM SW COR SEC 32

FINAL PROOF SURVEY UNDER

R-49219 R-5988
 Application No. 49220 Permit No. 36894...
 IN NAME OF

DONALD ROWLETT

Surveyed SEP. 19, 20 1974, by R.G. MUCKEN...