


G-5331
48723

T.37S. R.14E. W.M.

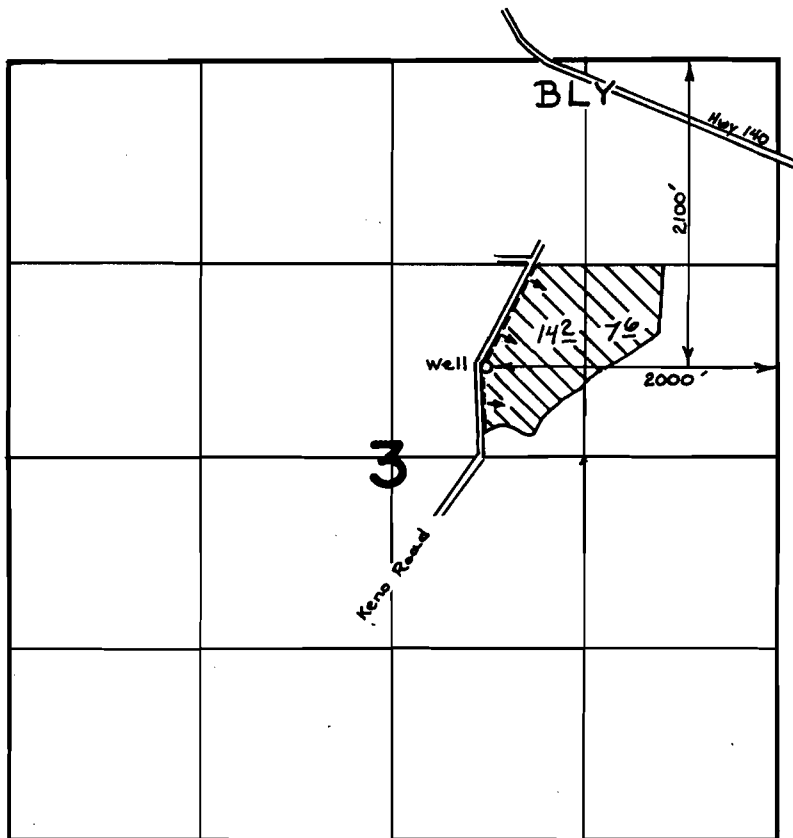

FINAL PROOF SURVEY UNDER

Application No. G-6490 Permit No. G-5331.
IN NAME OF

.....ROBERT C. & MILDRED CLARK

Surveyed AUG. 23 1977., by D. NORBY.....