


T.37S. R.IIE., W.M.

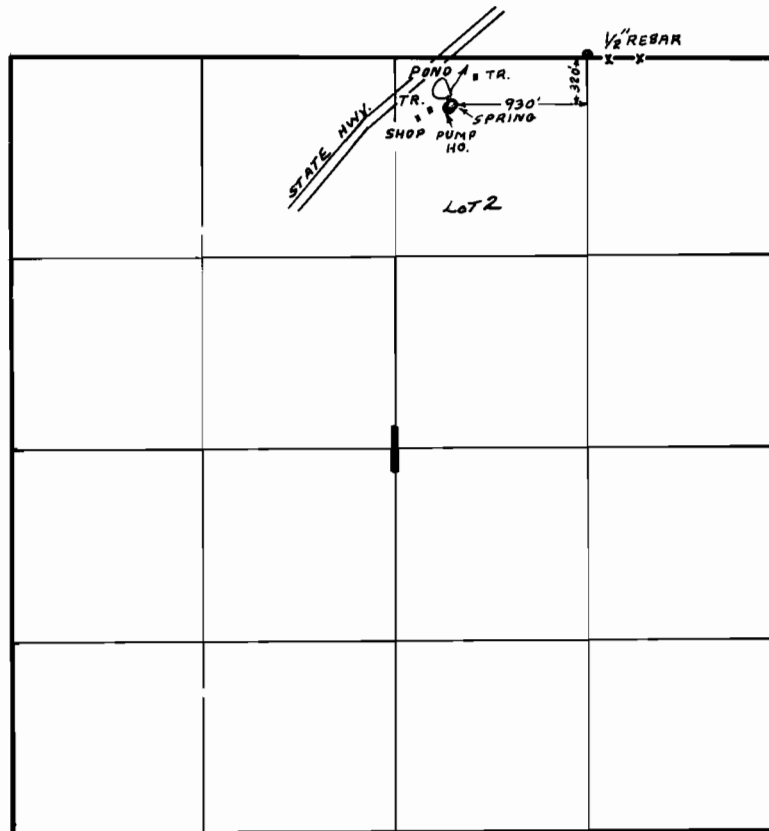

FINAL PROOF SURVEY
UNDER

Application No. 47864... Permit No. 35871...
IN NAME OF

BETTY & FRANK E. McBAIN, Jr.

Surveyed AUG. 2... 1978, by S.P. APPLEGATE