

SECTION

Application No. 56989

42889


Permit No. 42889

48727

TOWNSHIP 37S, RANGE 5E, W. M.

Scale 4" = 1 mile

North

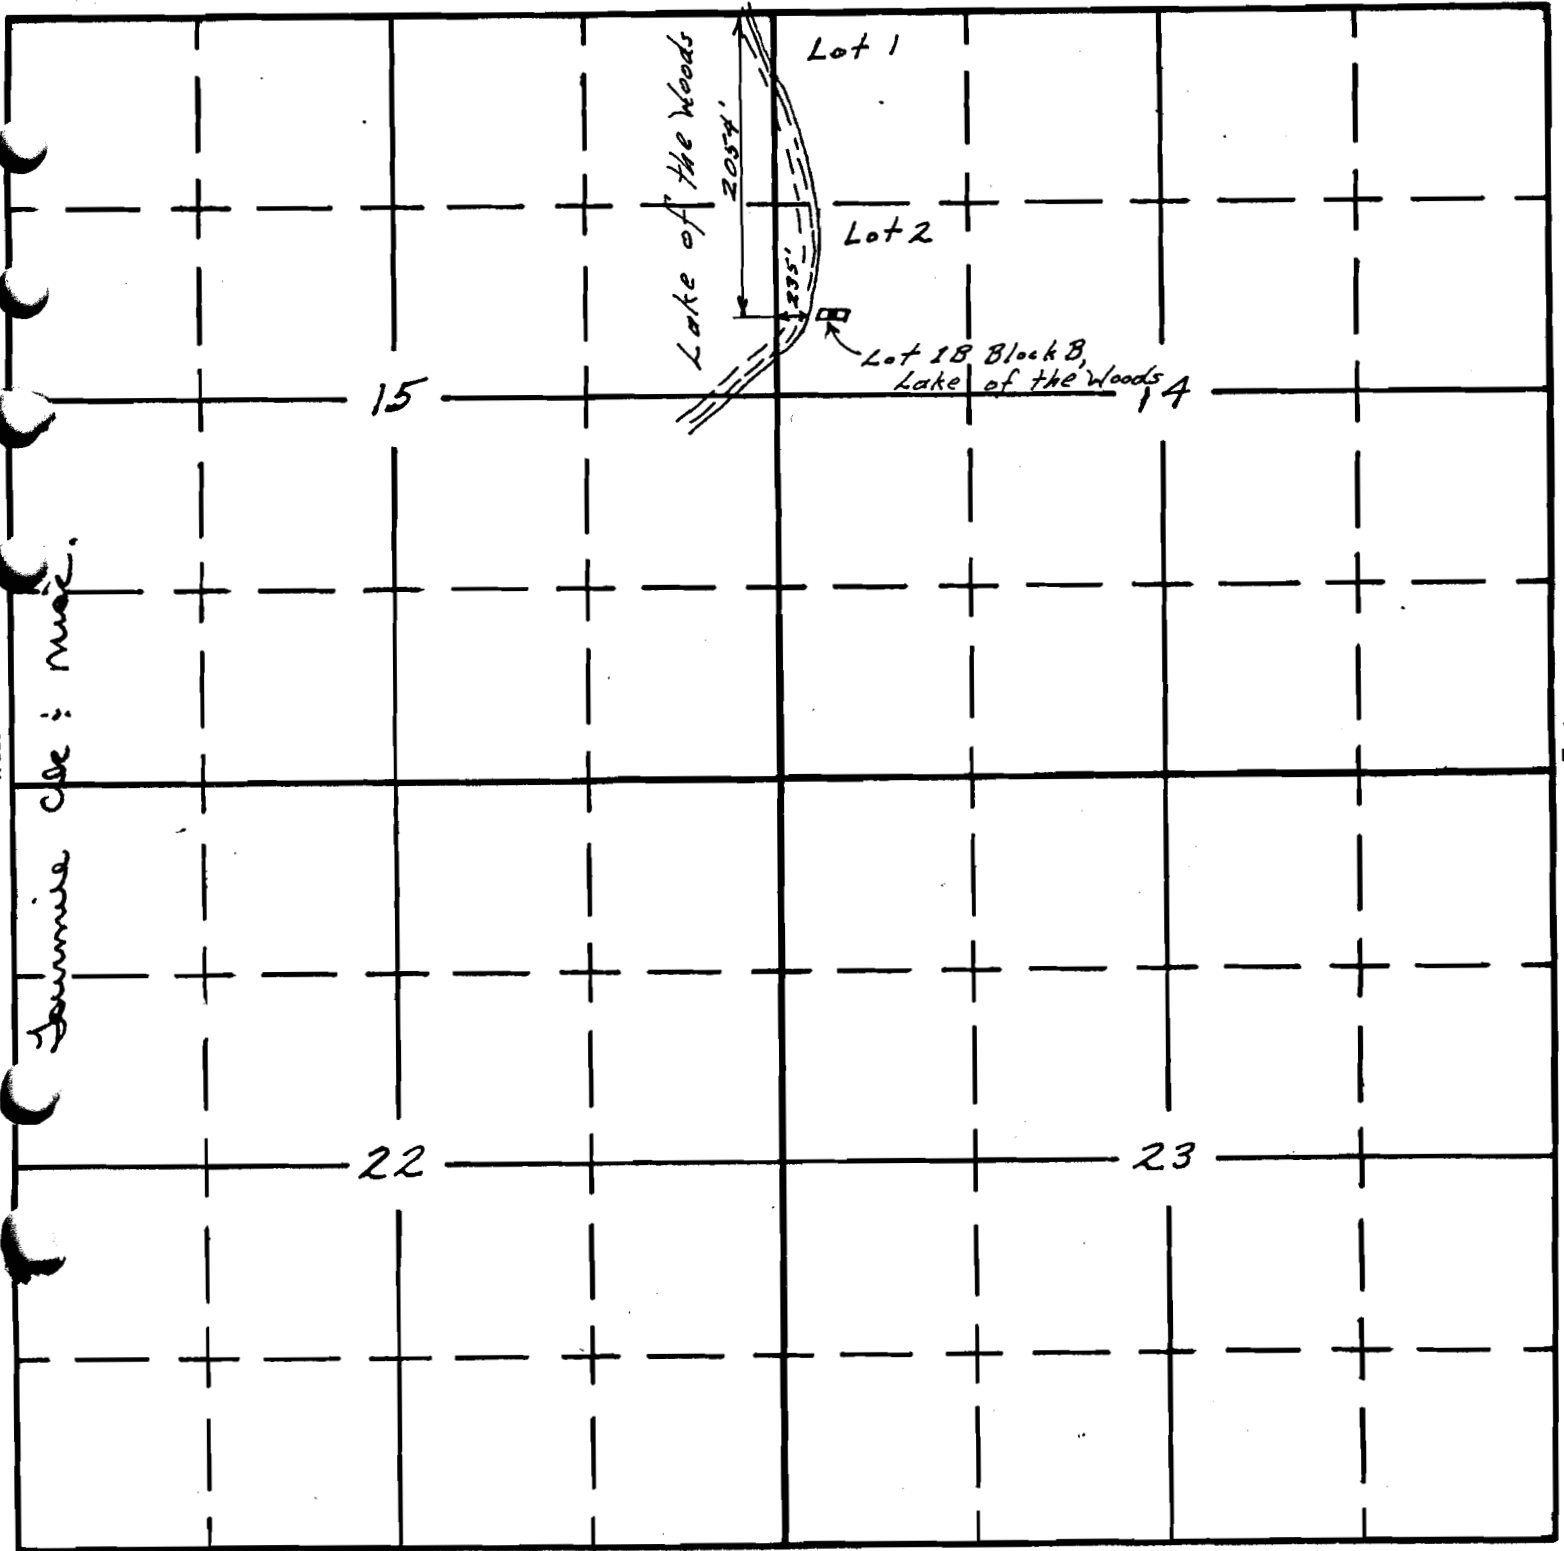

South

RECEIVED

APPLICATION No.

PERMIT No.

THIS MAP PREPARED BY:

[Signature]
FROM INFORMATION FURNISHED BY
THE APPLICANT.

WATER RESOURCES DEPT
SALEM, OREGON