


T.19S., R.12,W.,W.M.

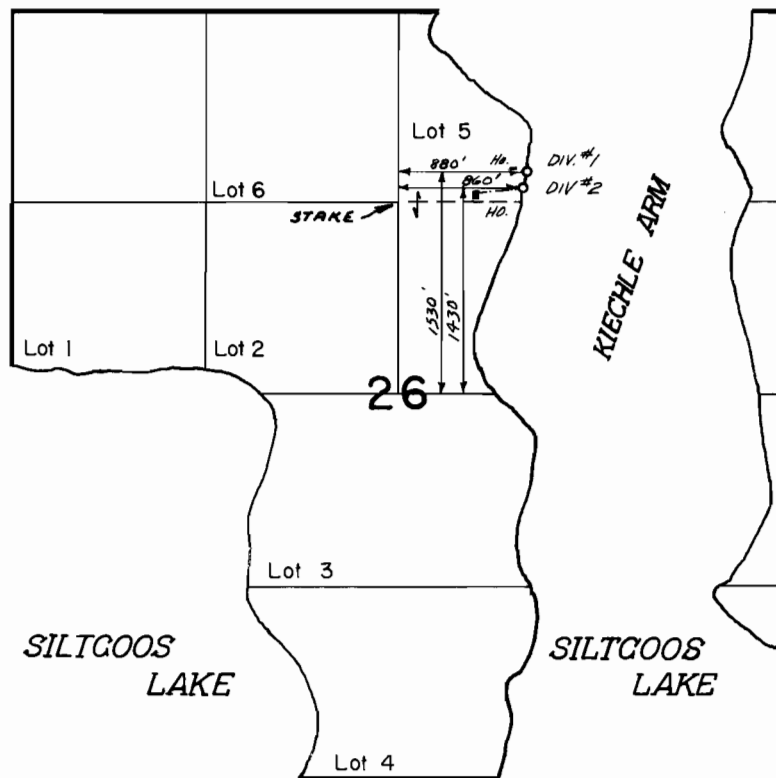

FINAL PROOF SURVEY
UNDER

Application No. 49243 Permit No. 36906
IN NAME OF

Clarence L. & Inez Haldorson

Surveyed MAY 17, 1978, by S.P. APPLEGATE