


G 7556

48733

T. 25 S. R. 17 E. W. M.

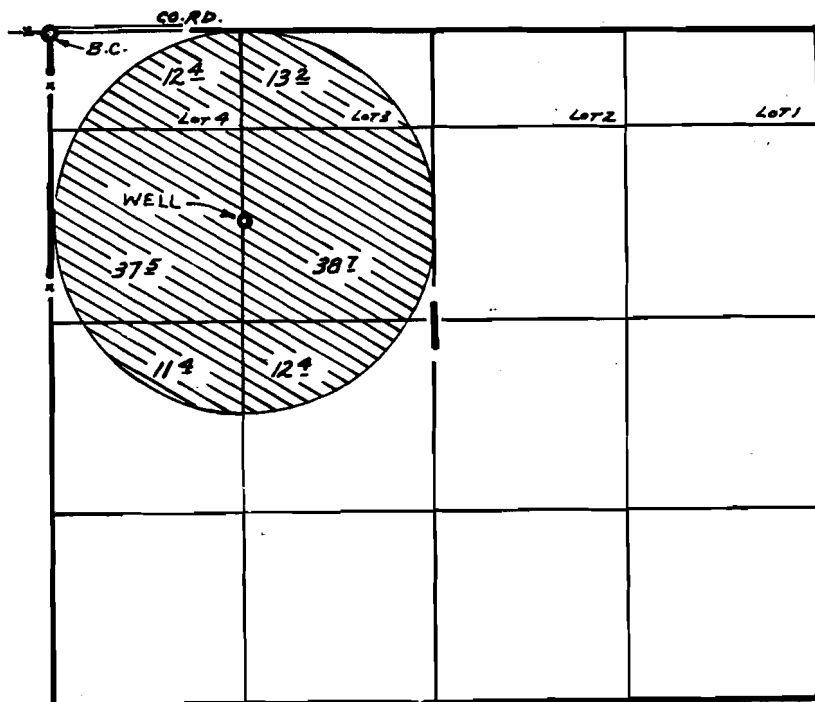

WELL LOC: 1320' S. & 1330' E. FROM N.W. COR. SEC. 1

FINAL PROOF SURVEY UNDER

Application No. ~~G-8308~~ Permit No. ~~G-7556~~
IN NAME OF.

.....*DOWER FARMS INC.*.....

Surveyed *AUG. 30, 1978.* by *S.P. APPLGATE*