
G7557
48734

T. 27 S. R. 16 E. W. M.

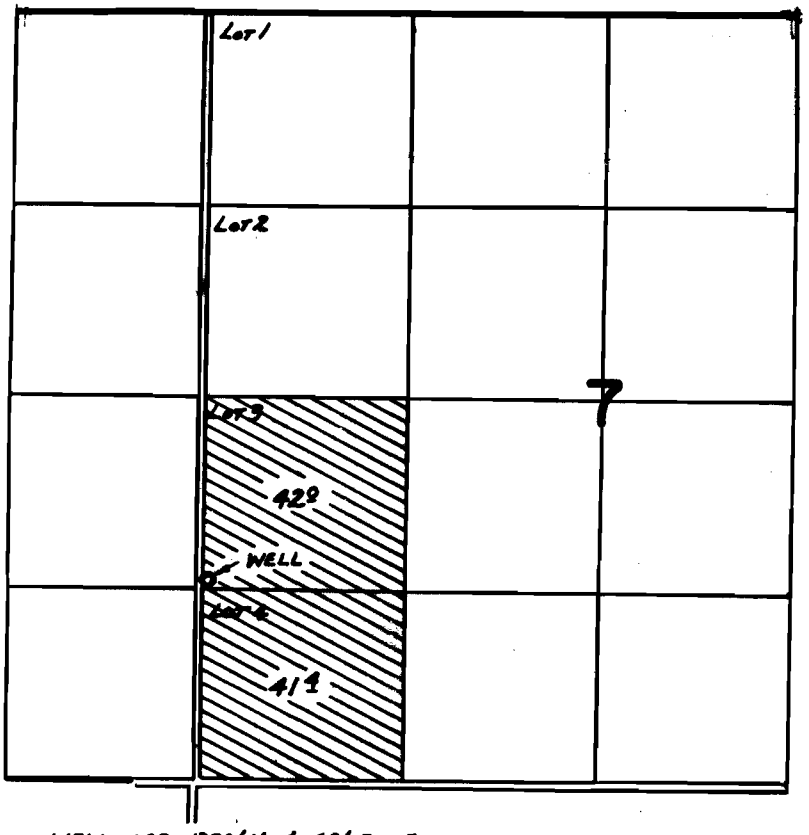

WELL LOC: 1380' N. & 60' E. FROM S.W. COR. SEC. 7

FINAL PROOF SURVEY
UNDER

Application No. G-8309 Permit No. G-7557
IN NAME OF

HARLIE E. BEAL

Surveyed AUG. 28 1978., by S.P. APPLEGATE

CNL-1KK-232 R-777