


G 7558
48735

T.26S.R.15E.W.M.

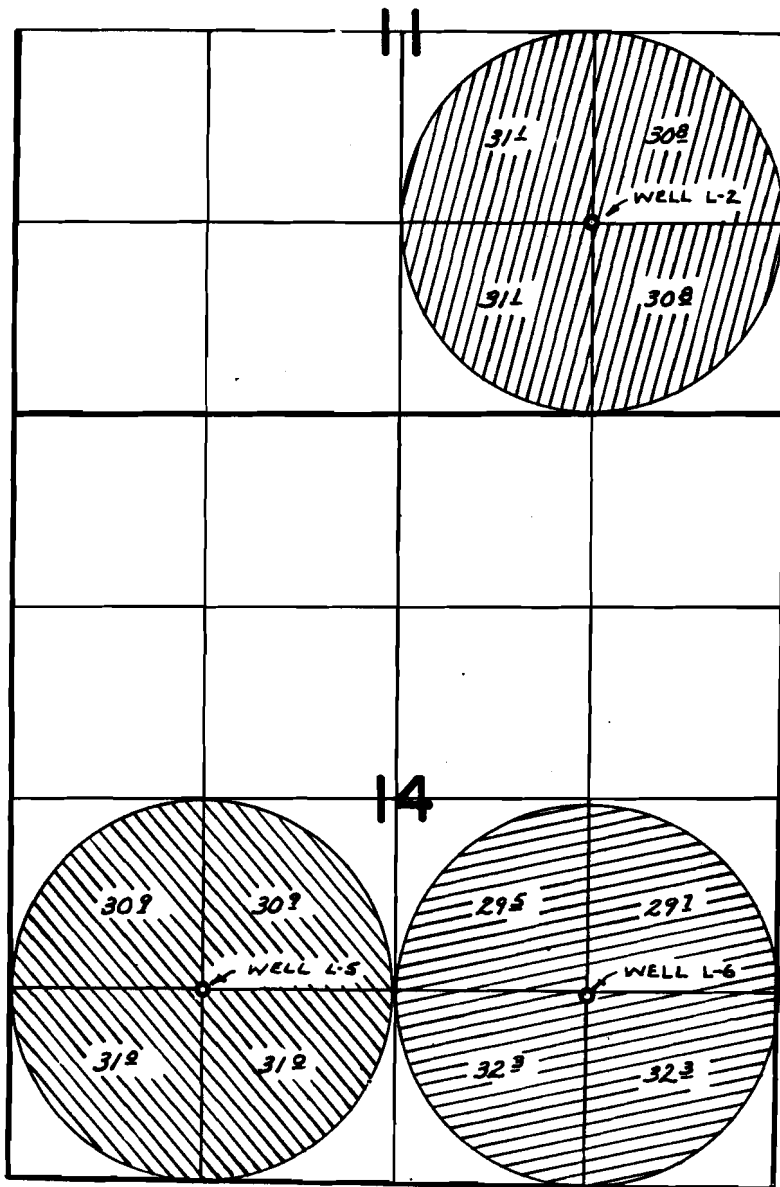

WELLS LOC: - 1320'S & 1330'W. FROM
E. & COR. SEC. 11; 1310'N. & 1320'E;
1320'N. & 3970'E., BOTH FROM
S.W. COR. SEC. 14

FINAL PROOF SURVEY UNDER

Application No. G-8310 Permit No. G-7558
G-8311 G-7559
G-8312 G-7560
IN NAME OF



.....DOWERS FARMS INC.....

Surveyed AUG. 29 1978., by S.P. APPLGATE