


G 7559

48736

## T.26S.R.15E.W.M.

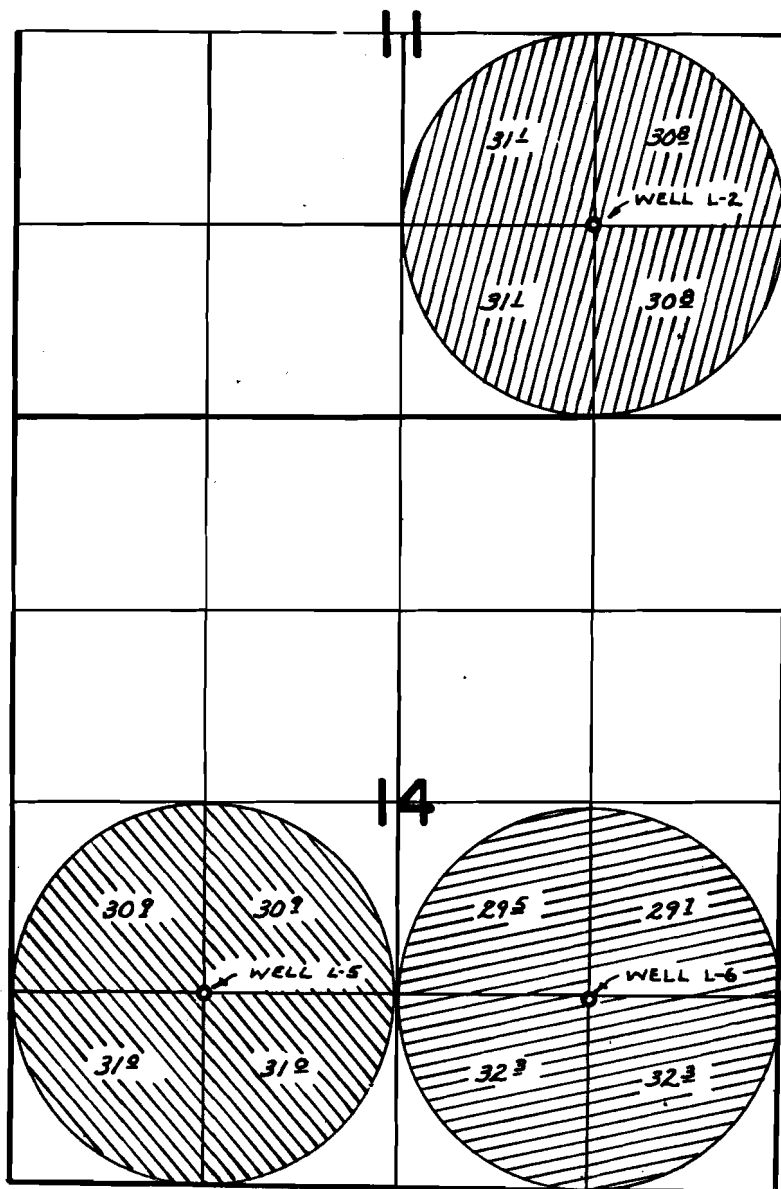

WELLS LOC: - 1320'S & 1330'W. FROM  
E & COR. SEC. 11; 1310'N. & 1320'E;  
1320'N. & 3970'E, BOTH FROM  
S.W. COR. SEC. 14

# FINAL PROOF SURVEY

UNDER

Application No. G-8310 Permit No. G-7558  
G-8311 G-7559  
G-8312 G-7560  
 IN NAME OF

DOWERS FARMS INC.

Surveyed AUG. 29 1978, by S. P. APPLGATE