


T.26S.R.16E.W.M.

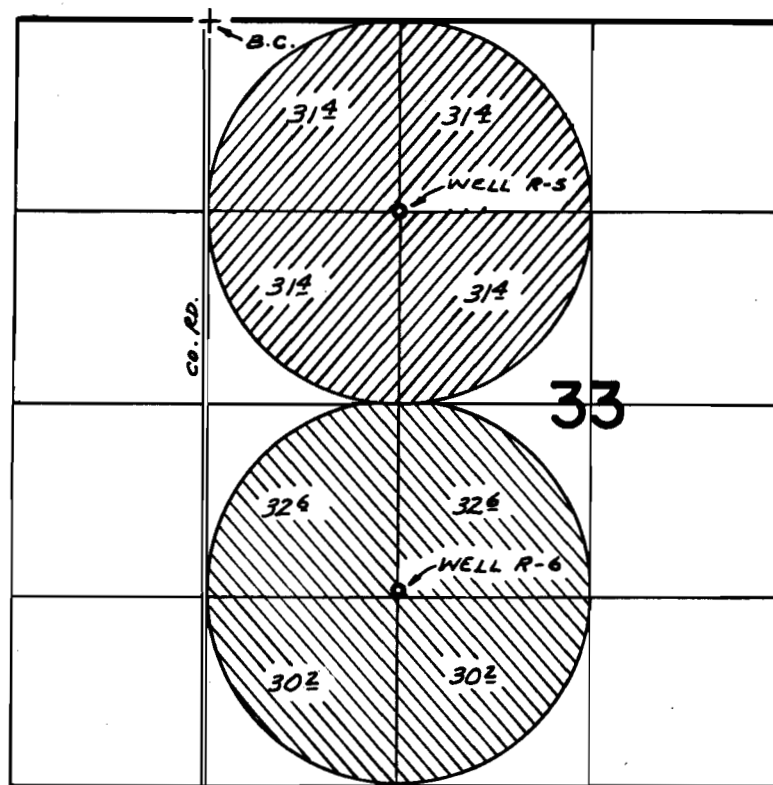

WELLS LOC: R-5 - 1310'S & 1310'E; R-6 - 3920'S & 1310'E,
BOTH FROM N.W. COR. SEC. 33

FINAL PROOF SURVEY UNDER

G-8788 G-8070 
Application No. ~~G-8789~~ Permit No. ~~G-8071~~ 
IN NAME OF

DOWER FARMS INC.

Surveyed AUG. 28, 1978, by S. P. APPLEGATE