


G 8071
48741

T.26S.R.16E.W.M.

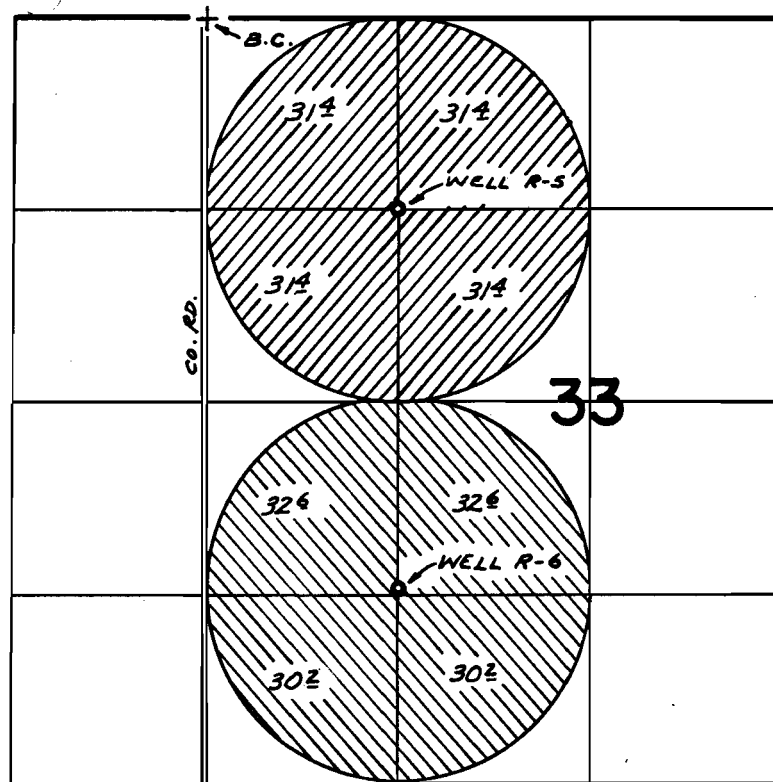

WELLS LOC: R-5 - 1310'S & 1310'E; R-6 - 3920'S. & 1310'E,
BOTH FROM N.W. COR. SEC. 33

FINAL PROOF SURVEY
UNDER

G-8768 G-8070 
Application No. G-8789 Permit No. G-8071 
IN NAME OF

DOWER FARMS INC.

Surveyed AUG. 28, 1978, by S. P. APPLIGATE