


T. 27S. R. 15&16E. W.M.

G 8072
48742

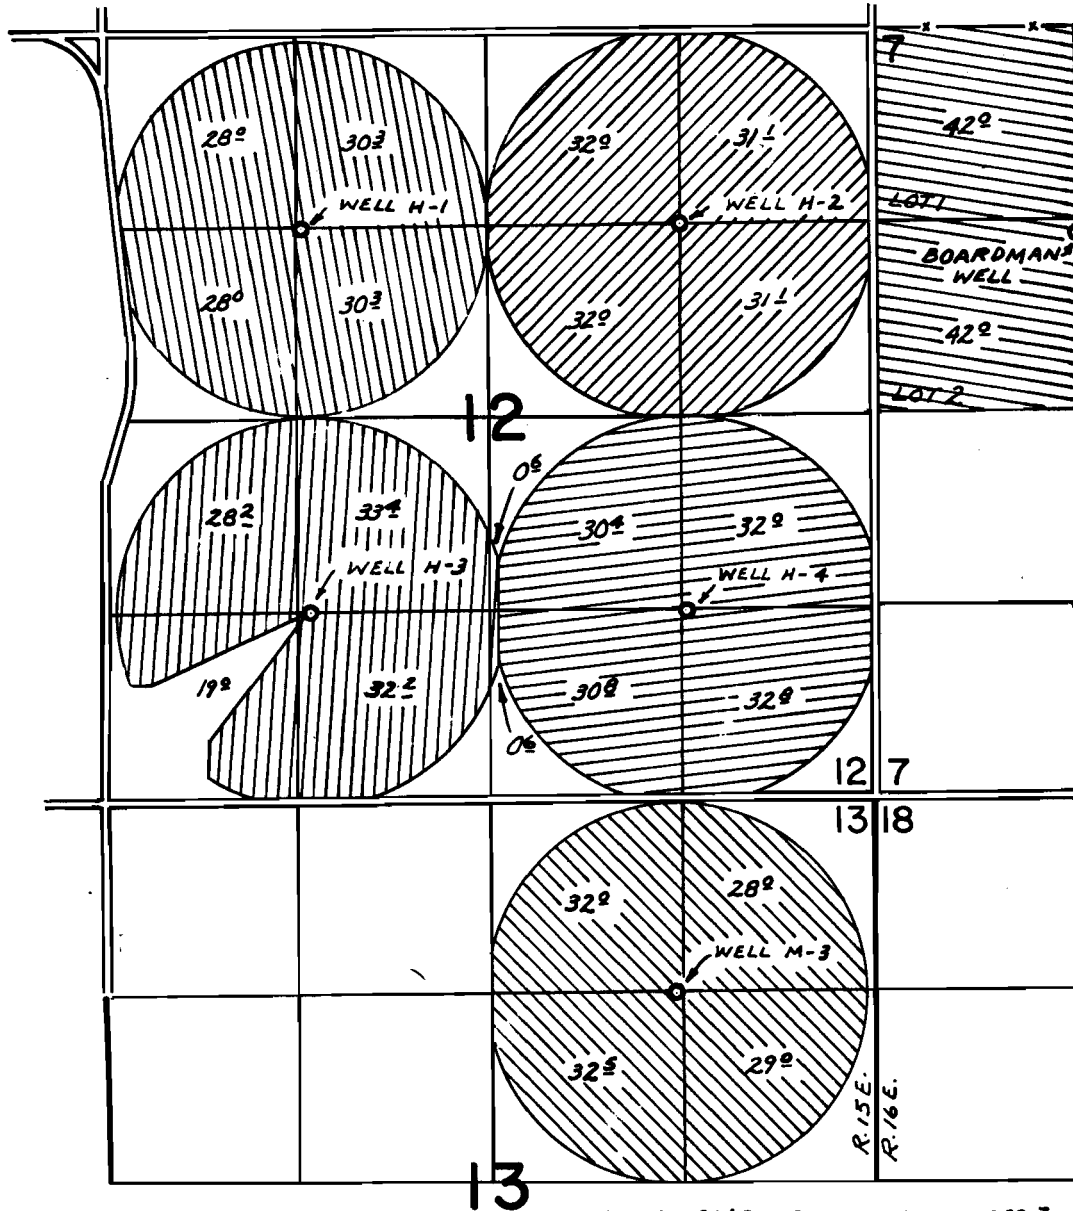

WELLS LOC: BOARDMAN WELL - 1430'S. & 1380'E. FROM N.W. COR. SEC. 7
WELL H-1 - 1330'S. & 3930'W;
H-2 - 1330'S. & 1320'W;
H-3 - 3960'S. & 3860'W;
H-4 - 3960'S. & 1280'W, ALL FROM N.E. COR. SEC. 12
M-3 - 1340'S. & 1370'W. FROM N.E. COR. SEC. 13

FINAL PROOF SURVEY

G-6756

G-8786

G-8787

G-8793

G-8794

G-8795

G-6007

G-8068

G-8069

G-8072

G-8073

G-8074

Application No. G-8795 Permit No. G-8074
IN NAME OF

DOWERS FARMS, INC.

Surveyed AUG. 29, 1978, by S. P. APPLIGATE