


T.10S.,R.1W.,W.M.

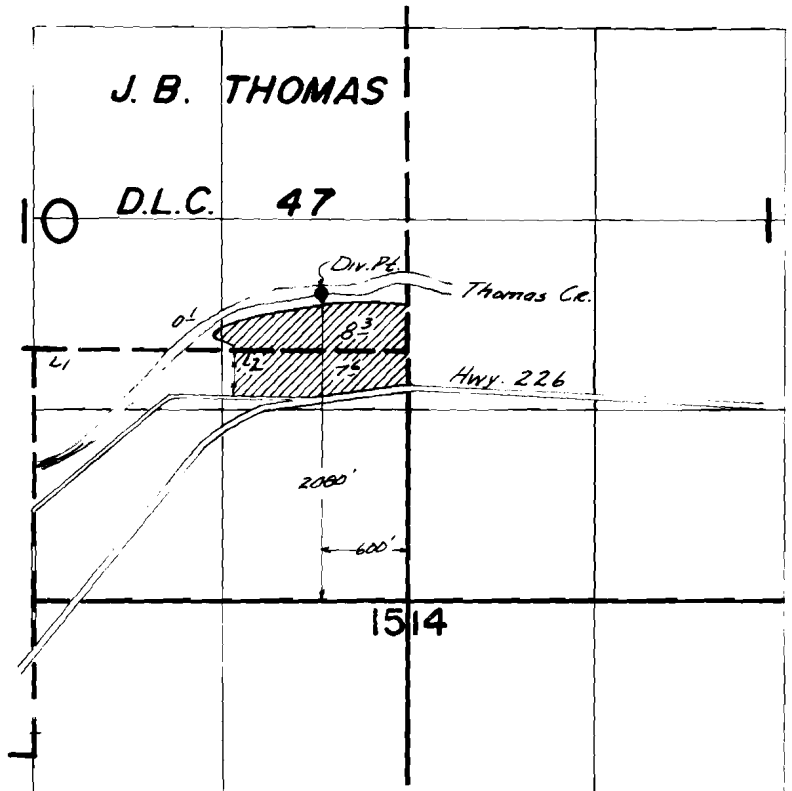

FINAL PROOF SURVEY
UNDER

Application No. 58482... Permit No. 44095...
IN NAME OF

J. LARRY GOSS

Surveyed Aug. 2... 1979., by S.C. BROWN