


T.18S.R.45E.W.M.

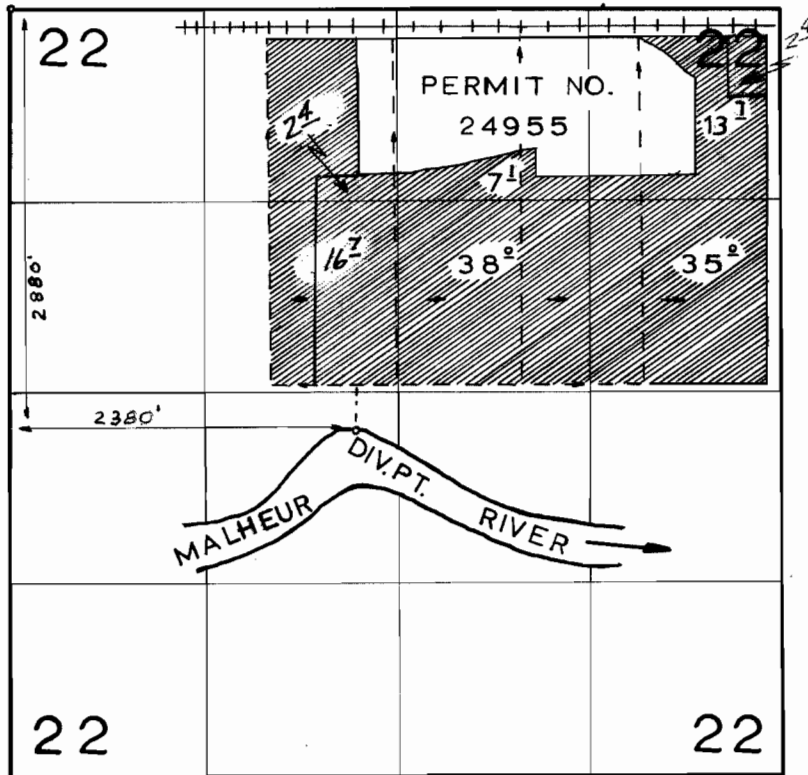

FINAL PROOF SURVEY
UNDER

Application No. 41019... Permit No. 30799
IN NAME OF

PHILIP E. BATT

Surveyed MARCH 22 1968, by F. E. LFERING