


T. 6S.R.3W.W.M.

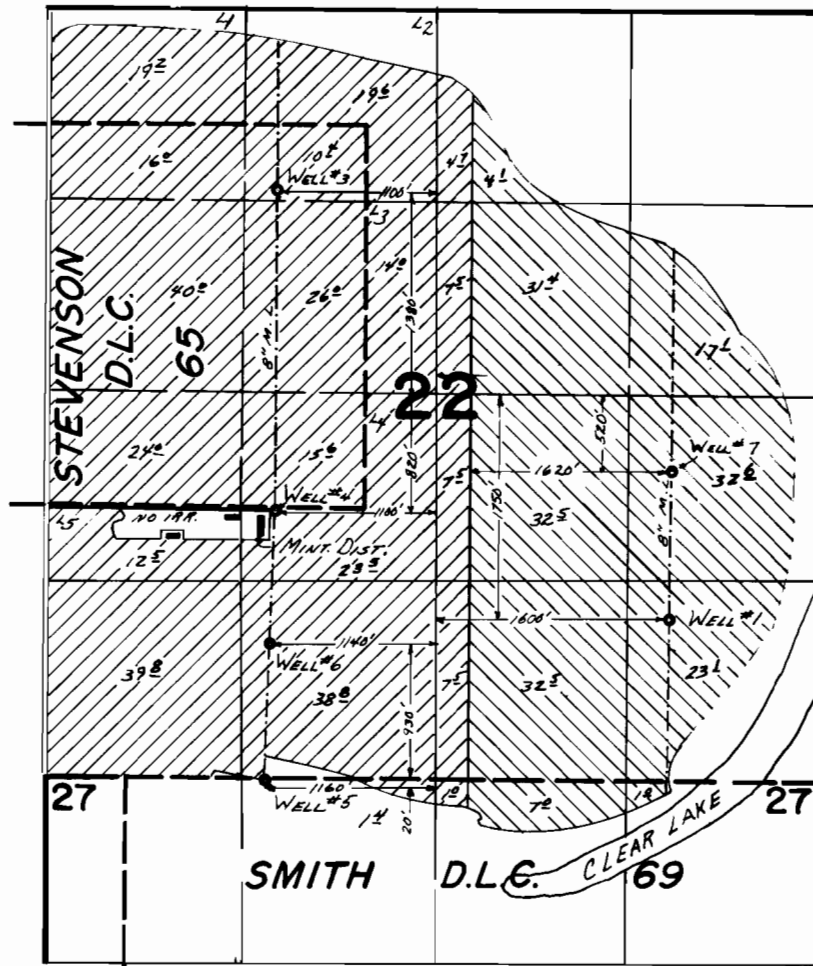

FINAL PROOF SURVEY UNDER

Application No. G-7807 G-7376
 G-7808 G-7377
 G-7810 Permit No. G-7378
 IN NAME OF MINT DISTILLERY

DALE TURNIDGE & DAVID TURNIDGE

Surveyed April 28 1978, by R.G.Mucken.....